


STATE OF KANSAS
STATE CORPORATION COMMISSION

Give All Information Completely
Make Required Affidavit
Mail or Deliver Report to:
Conservation Division
State Corporation Commission
800 Bittling Building
Wichita, Kansas

WELL PLUGGING RECORD

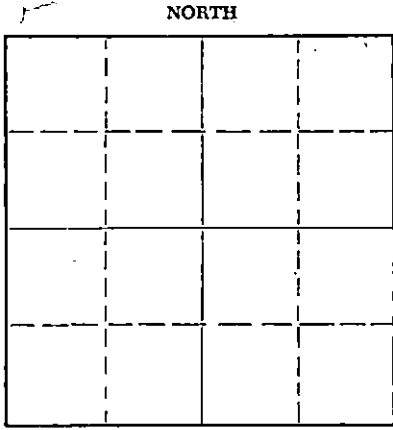

Pawnee County, Sec. 26 Twp. 21 Rge. 16W (E) (W)

Location as "NE/CNW/SW" or footage from lines NW SW NW

Lease Owner The Carl Todd Drilling Company

Lease Name Goldie Well No. 1

Office Address 404 KFH Building, Wichita, Kansas

Character of Well (completed as Oil, Gas or Dry Hole) Dry Hole

Date well completed 1-17 1955

Application for plugging filed 1-17 1955

Application for plugging approved 1-17 1955

Plugging commenced 1-17 1955

Plugging completed 1-17 1955

Reason for abandonment of well or producing formation Dry

If a producing well is abandoned, date of last production 19

Was permission obtained from the Conservation Division or its agents before plugging was commenced? Yes

Name of Conservation Agent who supervised plugging of this well M. A. Rives

Producing formation Depth to top Bottom Total Depth of Well 3890 Feet

Show depth and thickness of all water, oil and gas formations.

OIL, GAS OR WATER RECORDS

CASING RECORD

FORMATION	CONTENT	FROM	TO	SIZE	PUT IN	PULLED OUT
LOG ATTACHED						

Describe in detail the manner in which the well was plugged, indicating where the mud fluid was placed and the method or methods used in introducing it into the hole. If cement or other plugs were used, state the character of same and depth placed, from feet to feet for each plug set.

Filled hole with mud to 300', set plug and cemented with 20 sacks through drill pipe. Filled hole with mud to 35', set plug and cemented with 10 sacks to base of cellar.

1-25-55

(If additional description is necessary, use BACK of this sheet)

Name of Plugging Contractor The Carl Todd Drilling Company

Address 404 KFH Building, Wichita, Kansas

STATE OF KANSAS, COUNTY OF SEDGWICK, ss.

Carl Todd (employee of owner) or (owner or operator) of the above-described well, being first duly sworn on oath, says: That I have knowledge of the facts, statements, and matters herein contained and the log of the above-described well as filed and that the same are true and correct. So help me God


(Signature) Carl Todd

404 KFH Building, Wichita, Kansas (Address)

SUBSCRIBED AND SWORN to before me this 24th day of January, 1955

My commission expires December 14, 1957

Notary Public. (Signature)

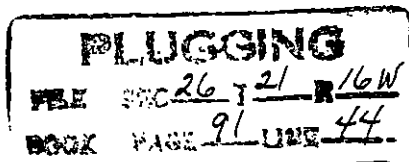

THE CARL TODD DRILLING COMPANY

404 KTH Building
Wichita, Kansas

#1 Goldie

NW SW NW Sec. 26-21-16W
Pawnee County, Kansas

COMMENCED: January 5, 1955

COMPLETED: January 17, 1955

ELEVATION: 1983 Kelly Bushing

CASING RECORD

0 - 100	Sand and gravel
100 - 200	Shale and shells
200 - 315	Shale and Red Bed
315 - 335	Sand
335 - 420	Shale and shells
420 - 520	Sand
520 - 530	Shale, shells, Red Bed
530 - 650	Shale and Red Bed
650 - 975	Shale and shells
975 - 980	Anhydrite
980 - 1400	Shale, shells and Red Bed
1400 - 1520	Shale and salt
1520 - 1835	Shale & shells
1835 - 2025	Shale and lime
2025 - 2330	Lime and shale
2330 - 2460	Lime and shale
2460 - 2595	Shale
2595 - 2885	Shale and lime
2885 - 2960	Shale
2960 - 3195	Lime and shale
3195 - 3250	Lime
3250 - 3319	Lime and shale
3319 - 3390	Lime
3390 - 3465	Lime and shale
3465 - 3770	Lime
3770 - 3820	Lime and chert
3820 - 3840	Cherty Cong.
3840 - 3875	Chert and shale
3875 - 3890	Lime
3890	Rotary Total Depth

8-5/8" 24# surface casing set at
980' cemented with 200 sacks.TOPS

Heebner	3383
Toronto	3402
Douglas	3419
Brown Lime	3484
Lansing	3494
Base K. C.	3730
Shale Cong.	3774
Chert Cong.	3779
Simpson	3850
Arbuckle	3881

DST #1 3792 - 3820

Weak blow for 7 minutes, intermittent
for balance of test, open 1 hour,
recovered 30' mud, no shows, BHP
160# in 20 minutes.

DST #2 3882 - 85

Fair to weak blow for 50 minutes,
open 1 hour, recovered 55' muddy water,
no shows. BHP 1050# in 20 minutes.

DST #3 3885 - 90

Weak steady blow thruout, open 1 hour,
recovered 70' muddy water with
sulfurous odor. No show. BHP 1050#
in 20 minutes.I hereby certify that the above is a true and correct log to the best
of my knowledge and belief.

THE CARL TODD DRILLING COMPANY

By: _____

*Carl Todd***PLUGGING**

PLUG	SEC	26	T	21	R	16W
BOOK	PAGE	91	LINE	44		