


WELL PLUGGING RECORD

Give All Information Completely
Make Required Affidavit
Mail or Deliver Report to:
Conservation Division
State Corporation Commission
800 Bittling Building
Wichita, Kansas

Pawnee County, Sec. 28 Twp. 21 Rge. 16 (W)
Location as "NE/CNW $\frac{1}{4}$ SW $\frac{1}{4}$ " or footage from lines C-NE/4 NE/4 SW/4
Lease Owner Sunray Oil Corporation
Lease Name Cora Brown Well No. 1
Office Address Box 195, Great Bend, Kansas
Character of Well (completed as Oil, Gas or Dry Hole) Oil
Date well completed 6/18 1949
Application for plugging filed 1/16 1950
Application for plugging approved 1/16 1950
Plugging commenced 7/25/50 1950
Plugging completed 8/1 1950
Reason for abandonment of well or producing formation An increase in water production to 100%.
If a producing well is abandoned, date of last production 6/20 1950
Was permission obtained from the Conservation Division or its agents before plugging was commenced? Yes

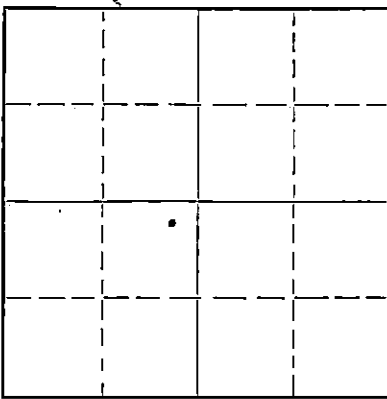

Locate well correctly on above Section Plat

Name of Conservation Agent who supervised plugging of this well C. D. Stough
Producing formation Arbuckle Depth to top 3852 Bottom 3875 $\frac{1}{2}$ Total Depth of Well 3875 $\frac{1}{2}$ Feet
Show depth and thickness of all water, oil and gas formations.

OIL, GAS OR WATER RECORDS

CASING RECORD

Formation	Content	From	To	Size	Put In	Pulled Out
Lsg.-KC	Water	3519'	3830'	8-5/8"	1011'	
Congl.	Water	3830'	3840'	5-1/2"	3879'	2794.98'
Simpson	Water	3840'	3852'			
Arbuckle	Oil & Water	3852'	3880'			

Describe in detail the manner in which the well was plugged, indicating where the mud fluid was placed and the method or methods used in introducing it into the hole. If cement or other plugs were used, state the character of same and depth placed, from _____ feet to _____ feet for each plug set.

From 3880' to 3853' filled w/rocks. From 3853' to 3824', 1 sax cement. Mud from 3824' to 2816'. Bridge set at 2816' to 2798' w/rocks & 2 sax cement. Mud in hole from top bridge to 265'. Rock bridge from 265' to 250'. 20 sax cement from 250' to 190'. Mud to 50', rock bridge to 35' and 10 sax cement to bottom of cellar. Cellar filled in w/dirt.

AUG 3 - 1950 8-3-50

(If additional description is necessary, use BACK of this sheet)

Correspondence regarding this well should be addressed to Sunray Oil Corporation
Address Box 195, Great Bend, Kansas

STATE OF KANSAS, COUNTY OF BARTON, ss.
H. S. Mann, employee of owner, of the above-described well,
being first duly sworn on oath, says: That I have knowledge of the facts, statements, and matters herein contained and the log of the above-described well as filed and that the same are true and correct. So help me God.

(Signature) H. S. Mann Engineer

Box 195, Great Bend, Kansas
(Address)

SUBSCRIBED AND SWORN TO before me this 2nd day of August, 1950

Notary Public

My commission expires April 19, 1952.

PLUGGING
FILE SEC-28T21 R16W
BOOK PAGE 134 LINE 2

Sunray Oil Corporation
 Philtower Building
 Tulsa, Oklahoma

June 14, 1949

Brown #1

NE/4 NE/4 SW/4
 Sec 28-21S-16W
 Pawnee County, Kans.

Contractor: STICKLE DRILLING COMPANY, Tulsa, Okla.

Started: May 20, 1949

Finished: June 5, 1949

DRILLER'S LOG

Cellar	0	5	
Clay and sand	5	95	
Shale, sand & shells	95	150	
Shale & shells	105	435	
Sand & shale	435	540	
Shale & shells	540	650	
Red bed & shells	650	805	
Shale & shells	805	1007	
Anhydrite	1007	1035	8-5/8" Csg. set @ 1014 w/ 525 sacks bulk cement.
Shale & shells	1035	1410	
Salt & shale	1410	1560	
Shale & shells	1560	1915	
Lime & shale	1915	2025	
Lime	2025	2100	
Shale & lime	2100	2110	
Cherty lime	2110	2130	
Lime & shale	2130	2235	
Lime	2235	2290	
Lime & shale	2290	2315	
Shale & lime	2315	2540	
Lime & shale	2540	2660	
Shale & Lime	2660	2920	
Lime & shale	2920	2965	
Shale & lime	2965	3135	
Lime & shale	3135	3206	
Lime	3206	3498	
Lime & shale	3498	3520	
Lime	3520	3610	
Cherty lime	3610	3643	
Lime	3643	3808	
Shale & lime	3808	3830	
Conglomerate	3830	3850	
Lime	3850	3879 1/2	TD KB

5-1/2" Csg. set @ 3879' KB with 150 sacks bulk cement.

State of Kansas ()
 County of Barton (ss)

1950

I, Fred E. Stickle, do hereby certify that the above is a true and complete log of the Sunray Oil Corporation's #1 Brown located in the NE/4 NE/4 SW/4 of section 28-21S-16W, Pawnee County, Kansas.

Fred E. Stickle

Sworn to and subscribed before me this 14th day of June, 1949.

My Commission Expires April 19, 1952

Martha Scott
 Notary Public

PLUGGING
 FILE SEC 28-21S-16W
 BOOK PAGE 124 LINE 2