


STATE OF KANSAS
 STATE CORPORATION COMMISSION
 CONSERVATION DIVISION
 P. O. BOX 17027
 WICHITA, KANSAS 67217

FORM CP-4

WELL PLUGGING RECORD

Finney County, Sec. 16 Twp. 21S Rge. 27 (W)

Location as "NE/CNW/SW" or footage from lines C SW SW
 Lease Owner National Oil Company
 Lease Name RAMSEY Well No. #1
 Office Address 200 W. Douglas, Suite 550, Wichita, Kansas 67202
 Character of Well (completed as Oil, Gas or Dry Hole) Dry Hole
 Date well completed February 29, 1976
 Application for plugging filed (verbal) February 29, 1976
 Application for plugging approved (verbal) February 29, 1976
 Plugging commenced February 29, 1976
 Plugging completed February 29, 1976
 Reason for abandonment of well or producing formation No commercial quantity of oil or gas encountered.
 If a producing well is abandoned, date of last production 19
 Was permission obtained from the Conservation Division or its agents before plugging was commenced? Yes

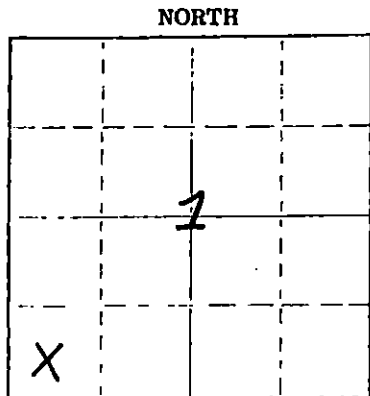

Locate well correctly on above Section Plot

Name of Conservation Agent who supervised plugging of this well Clarence Thomas, Jr.
 Producing formation _____ Depth to top _____ Bottom _____ Total Depth of Well 4700
 Show depth and thickness of all water, oil and gas formations.

OIL, GAS OR WATER RECORDS

CASING RECORD

FORMATION	CONTENT	FROM	TO	SIZE	PUT IN	PULLED OUT
				8 5/8"	319'	none

Describe in detail the manner in which the well was plugged, indicating where the mud fluid was placed and the method or methods used in introducing it into the hole. If cement or other plugs were used, state the character of same and depth placed, from _____ feet to _____ feet for each plug set.

1st Plug was Set @ 900' with 70 sx. cement
 2nd Plug was Set @ 300' with 20 sx. cement
 3rd Plug was Set @ 40' with 10 sx. cement
 Plug was down @ 9:30 p.m. February 29, 1976

RECEIVED
 STATE CORPORATION COMMISSION

MAR 09 1976

Name of Plugging Contractor Abercrombie Drilling, Inc. (If additional description is necessary, use BACK of this sheet)
 Address 801 Union Center, Wichita, Kansas 67202

CONSERVATION DIVISION
 WICHITA, KANSAS

STATE OF KANSAS COUNTY OF SEDGWICK ss.

Jerry A. Langrehr-Exec. V.P.

(employee of owner) or (owner or operator) of the above-described


well, being first duly sworn on oath, says: That I have knowledge of the facts, statements, and matters herein contained and the log of the above-described well as filed and that the same are true and correct. So help me God.

(Signature) Jerry A. Langrehr
801 Union Center, Wichita, Kansas 67202
 (Address)

SUBSCRIBED AND SWORN TO before me this 8th day of March, 1976

My commission expires February 18, 1980

Diane Steincamp
 Diane Steincamp
 Notary Public.

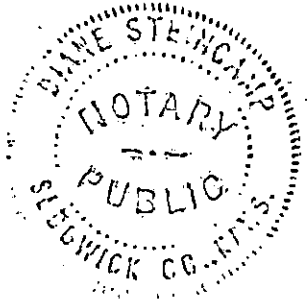

CONTRACTOR'S WELL LOG

15.055-20219-0000

OPERATOR: National Oil Company
 CONTRACTOR: Abercrombie Drilling, Inc.
 WELL NAME: RAMSEY #1
 LOCATION: C SW SW Section 10-21S-27W
 Finney County, Kansas
 SPUD DATE: February 19, 1976
 COMPLETION DATE: February 29, 1976

0	1320	Sand & Shale
1320	2735	Shale
2735	3455	Shale & Lime
3455	4127	Lime & Shale
4127	4225	Shale & Lime
4225	4700	Lime & Shale
	4700	Rotary Total Depth

Spudded in @ 6:00 p.m. February 18, 1976. Drilled 320' of 12 1/4" hole. Tallied 306'. Set 8 jts. of 8 5/8" casing @ 319'. Cemented with 200 sx. of Common, 2% gel, 3% ca. cl. Cement did circ. Plug was down @ 4:00 a.m. February 19, 1976.

Plugged and Abandoned: 1st Plug was Set @ 900' with 70 sx. cement; 2nd Plug was Set @ 300' with 20 sx. cement; 3rd Plug was Set @ 40' with 10 sx. cement; Rat hole with 2 sx. cement. 2% gel, 3% ca. cl. State Plugger: Clarence Thomas, Jr. Plug was down @ 9:30 p.m. February 29th.

SAMPLE TOPS:

Anhydrite 1942'
 B/Anhydrite 1978'

RECEIVED
 STATE COMMISSION COMMISSIONER

MAR 09 1976

CONSERVATION DIVISION
 Wichita, Kansas

STATE OF KANSAS)
) SS
 COUNTY OF SEDGWICK)

Jerry A. Langrehr, Exec. Vice President of Abercrombie Drilling, Inc., does hereby state that the above and foregoing is a true and correct copy of the log of the Ramsey #1 C SW SW Sec. 1-21S-27W, Finney County, Kansas.

ABERCROMBIE DRILLING, INC.

By: Jerry A. Langrehr
 Jerry A. Langrehr - Exec. V.P.

Subscribed and sworn to before me, a Notary Public, in and for the aforesaid county and state as of this 8th day of March, 1976.

My Commission Expires: February 18, 1980

Diane Steincamp
 Diane Steincamp - Notary Public

