


STATE OF KANSAS
STATE CORPORATION COMMISSION

WELL PLUGGING RECORD

Give All Information Completely
Make Required Affidavit
Mail or Deliver Report to:
Conservation Division
State Corporation Commission
211 No. Broadway
Wichita, Kansas

Finney County. Sec. 22 Twp. 21S Rge. 28W (E) (W)
Location as "NE/CNW%SW%" or footage from lines C SW SW

Lease Owner Gene Goff - / Sierra Petrol - Contr.
Lease Name CHENNEL Well No. 1
Office Address / 420 W. Douglas Ave., Wichita, Ks.
Character of Well (completed as Oil, Gas or Dry Hole) dry
Date well completed 7/21/57 19
Application for plugging filed 7/19/57 19
Application for plugging approved 7/19/57 19
Plugging commenced 7/20/57 19
Plugging completed 7/20/57 19
Reason for abandonment of well or producing formation dry

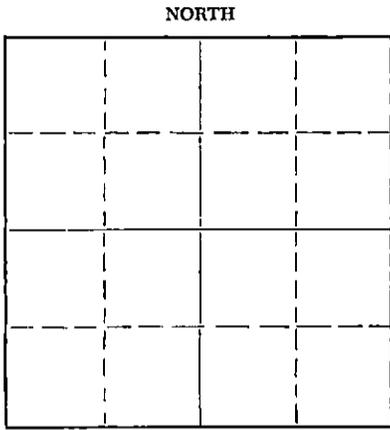

Locate well correctly on above
Section Plat

If a producing well is abandoned, date of last production _____ 19____
Was permission obtained from the Conservation Division or its agents before plugging was commenced? yes Murl Rives

Name of Conservation Agent who supervised plugging of this well _____
Producing formation _____ Depth to top _____ Bottom _____ Total Depth of Well 4761 Feet
Show depth and thickness of all water, oil and gas formations.

OIL, GAS OR WATER RECORDS

CASING RECORD

FORMATION	CONTENT	FROM	TO	SIZE	PUT IN	PULLED OUT
				8 5/8	400	none

Describe in detail the manner in which the well was plugged, indicating where the mud fluid was placed and the method or methods used in introducing it into the hole. If cement or other plugs were used, state the character of same and depth placed, from _____ feet to _____ feet for each plug set.

PLUGGING RECORD

Filled with mud from 4761 to 390'. Set wood plug, 1/3 sack hulls and 20 sacks cement. Filled with mud from 390' to 35', Set wood plug 1/3 sack hulls and 10 sacks cement. up to base of cellar.

(If additional description is necessary, use BACK of this sheet)

Name of Plugging Contractor Sierra Petroleum Co., Inc.
Address 420 W. Douglas Ave., Wichita, Kansas

STATE OF KANSAS COUNTY OF RUSSELL, ss.
T. R. Sullivan (employee of owner) or (owner or operator) of the above-described well, being first duly sworn on oath, says: That I have knowledge of the facts, statements, and matters herein contained and the log of the above-described well as filed and that the same are true and correct. So help me God.

(Signature) T.R. Sullivan

(Address)

SUBSCRIBED AND SWORN TO before me this 26th day of July, 19 57

My commission expires 1-30-61.

Margie Cooper

RECEIVED
Notary Public
STATE CORPORATION COMMISSION

PLUGGING
FILE SEC 22 T. 21 R. 28W
BOOK PAGE 29 LINE 33

7-29-57

JUL 29 1957
CONSERVATION DIVISION
Wichita, Kansas

Gene Goff - Owner

Sierra Petroleum - Contr.

CHENNELL #1

C SW SW Sec. 22-21S-28W
Finney County, Kansas

Total Depth: 4761'

Elev: 2757' KB

Comm: 7/1/57
Comp: 7/21/57

Casings:

Cement

8 5/8 @ 400'

w/200 sacks cement

FORMATION	DEPTH
Shale	480
Sand & shale	700
Shale	960
Sand & shale	1170
Shale & shells	1420
Shale, shells & red bed	1760
Lime & shale	2957
Lime	2995
Lime & shale	3071
Lime	4652
Miss	4668
Miss & lime	4713
Miss	4761

Tops:		DEPTH
Winfield		2780
Florence		2930
Topeka		3708
Heebner		3969
Toronto		3977
Lans. J. C.		3999
Miss		4660

STATE OF KANSAS)
) ss:
COUNTY OF RUSSELL)

I hereby certify that the above information is true and correct to the best of my knowledge.

T. R. Sullivan

Subscribed and sworn to before me this 26th day of July, 1957.

Margie Cooper
Notary Public

My commission expires: 1-30-61.

PLUGGING
FILE SEC 22 T. 21 R. 28W
BOOK PAGE 29 LINE 33

RECEIVED
STATE CORPORATION COMMISSION
JUL 29 1957
CONSERVATION DIVISION
Wichita, Kansas

