


STATE OF KANSAS
STATE CORPORATION COMMISSION

Form CP-4

WELL PLUGGING RECORD

Give All Information Completely
Make Required Affidavit
Mail or Deliver Report to:
Conservation Division
State Corporation Commission
211 No. Broadway
Wichita, Kansas

Finney County. Sec. 30 Twp. 21S Rge. 29W (E) (W)
Location as "NE/CNW/SW" or footage from lines SW SE NW
Lease Owner Thunderbird Drilling, Inc.
Lease Name Hmd "F" Well No. 1
Office Address P.O. Box 18407- Wichita, Ks. 67218
Character of Well (completed as Oil, Gas or Dry Hole) Dry Hole
Date well completed 7/9/80 19
Application for plugging filed 7/9/80 19
Application for plugging approved 7/9/80 19
Plugging commenced 7/9/80 19
Plugging completed 7/9/80 19
Reason for abandonment of well or producing formation Dry Hole
If a producing well is abandoned, date of last production _____ 19
Was permission obtained from the Conservation Division or its agents before plugging was commenced? Yes

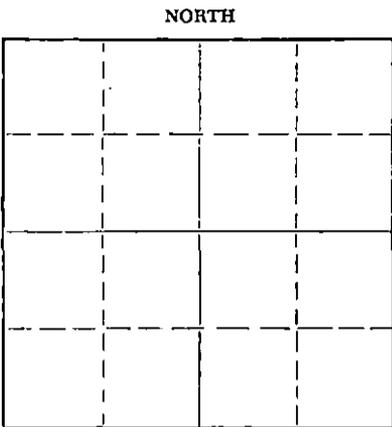

Locate well correctly on above
Section Plat

Name of Conservation Agent who supervised plugging of this well Gilbert Balthazor
Producing formation _____ Depth to top _____ Bottom _____ Total Depth of Well 4950 Feet
Show depth and thickness of all water, oil and gas formations.

OIL, GAS OR WATER RECORDS

CASING RECORD

FORMATION	CONTENT	FROM	TO	SIZE	PUT IN	PULLED OUT
	Surf. Csg.			8 5/8"	389'	None

Describe in detail the manner in which the well was plugged, indicating where the mud fluid was placed and the method or methods used in introducing it into the hole. If cement or other plugs were used, state the character of same and depth placed, from _____ feet to _____ feet for each plug set.
1st plug @ 380' w/50 sx
2nd plug @ 40' w/10 sx
5 sx in rathole

8-4-80
RECEIVED
STATE CORPORATION COMMISSION
AUG 2 1980
CONSERVATION DIVISION
Wichita, Kansas


(If additional description is necessary, use BACK of this sheet)
Name of Plugging Contractor Thunderbird Drilling, Inc.
Address P.O. Box 18407- Wichita, Ks. 67218

STATE OF KANSAS, COUNTY OF SEDGWICK, ss.
Burke Krueger (employee of owner) or (owner or operator) of the above-described well, being first duly sworn on oath, says: That I have knowledge of the facts, statements, and matters herein contained and the log of the above-described well as filed and that the same are true and correct. So help me God.

(Signature) Burke Krueger

SUBSCRIBED AND SWORN TO before me this 1st day of August, 19 80

My commission expires 3-25-84
Gloria DeJesus
Gloria DeJesus Notary Public.

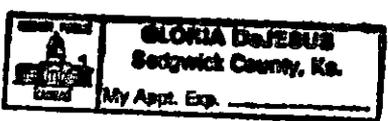

DRILLERS LOG

Company Thunderbird Drilling, Inc.

Contractor Thunderbird Drilling, Inc

Elevation 2692' K.B.

Farm Hund "F"

Well No. 1

Casing 8 5/8" @ 389' w/270 sx

Location SW SE NW, Sec. 30-21S-29W

County Finney County, Ks.

Production

<u>From</u>	<u>To</u>	<u>Description</u>
0	389	Surface Hole
389	772	Shale
772	1280	Sand & shale
1280	2146	Shale
2146	2215	Anhydrite
2215	2862	Shale & Shells
2862	3136	Shale
3136	3628	Shale & Lime
3628	3761	Lime & Shale
3761	2940	Lime
4950	R.T.D.	

RECEIVED
STATE CORPORATION COMMISSION
AUG - 4 1980
CONSERVATION DIVISION
Wichita, Kansas

STATE OF KANSAS)
) ss.
COUNTY OF SEDGWICK)

I, Burke Krueger, of Thunderbird Drilling, Inc. upon oath states that the above and foregoing is a true and correct copy from the Daily Drilling Report from your Hund "F" #1.

Burke Krueger

Subscribed and sworn to before me this 1st day of August, 1980

Gloria DeJesus
Gloria DeJesus Notary Public

My commission expires: 3-25-84

