


Give All Information Completely
Make Required Affidavit
Mail or Deliver Report to:
Conservation Division
State Corporation Commission
212 No. Market
Wichita, Kansas

WELL PLUGGING RECORD

NORTH

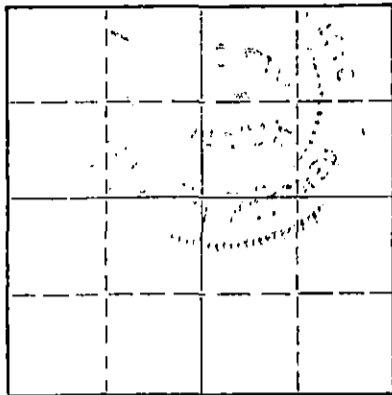

Locate well correctly on above
Section Plat

Stafford County. Sec. 20 Twp. 23 Rge. 14 (E) W (W)
Location as "NE/CNW/SW" or footage from lines SW NE NE
Lease Owner Rosen Oil Company
Lease Name Cornwall Well No. B#1
Office Address Wichita, Kansas 67202
Character of Well (completed as Oil, Gas or Dry Hole)
Date well completed 19__
Application for plugging filed 19__
Application for plugging approved 19__
Plugging commenced 4/19/68 19__
Plugging completed 4/24/68 19__
Reason for abandonment of well or producing formation depleted.

If a producing well is abandoned, date of last production 19__
Was permission obtained from the Conservation Division or its agents before plugging was commenced? yes

Name of Conservation Agent who supervised plugging of this well Justice
Producing formation _____ Depth to top _____ Bottom _____ Total Depth of Well 4063 Feet
Show depth and thickness of all water, oil and gas formations.

OIL, GAS OR WATER RECORDS

CASING RECORD

FORMATION	CONTENT	FROM	TO	SIZE	PUT IN	PULLED OUT
				8-5/8"	226'	none
				4 1/2"	4060'	2935'

Describe in detail the manner in which the well was plugged, indicating where the mud fluid was placed and the method or methods used in introducing it into the hole. If cement or other plugs were used, state the character of same and depth placed, from _____ feet to _____ feet for each plug set.

Checked hole, pushed plug to 3650', 50 gal. sand and 3 sacks of cement. Rigged up on 4 1/2" casing, worked pipe to 27" tension, worked pipe, no change in tension. Loaded hole, checked hole, shot pipe at 3138', 3027', 2923', worked pipe loose and pulled 92 joints of 4 1/2" casing. Set 10' rock bridge at 200' and mixed and dumped 10 sacks of cement with bailer, let set overnight. Bailed hole dry, dumped 15 sacks of cement, mudded hole to 40', 10' rock bridge and ran 10 sacks of cement. Talled pipe.

PLUGGING COMPLETE.

RECEIVED
STATE CORPORATION COMMISSION
MAY 7 1968
CONSERVATION DIVISION
Wichita, Kansas

(If additional description is necessary, use BACK of this sheet)

Name of Plugging Contractor KNIGHT CASING PULLING COMPANY, INC.
Address CHASE, KANSAS

STATE OF KANSAS COUNTY OF KANSAS, ss.
NOEL J. KNIGHT

(employee of owner) or (owner or operator) of the above-described well, being first duly sworn on oath, says: That I have knowledge of the facts, statements, and matters herein contained and the log of the above-described well as filed and that the same are true and correct. So help me God.


(Signature)

Noel J. Knight

CHASE, KANSAS

(Address)

Subscribed and sworn to before me this 25th day of April, 1968

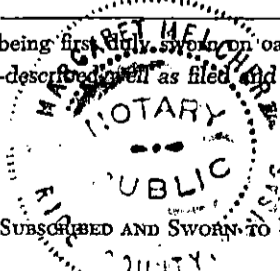

Margaret Melcher
Notary Public.

My commission expires February 15, 1971