


STATE OF KANSAS  
STATE CORPORATION COMMISSION

Give All Information Completely  
Make Required Affidavit  
Mail or Deliver Report to:  
Conservation Division  
State Corporation Commission  
800 Bitting Building  
Wichita, Kansas

WELL PLUGGING RECORD

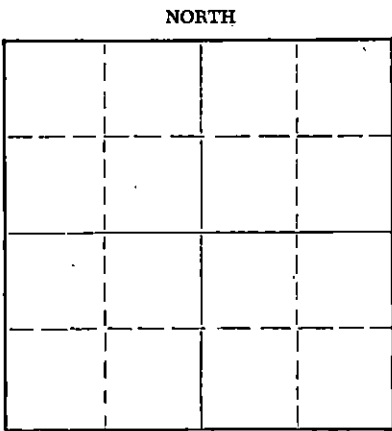

McPherson County, Sec. 11 Twp 21 Rge. 2 (W)  
Location as "NE/CNW/SW" or footage from lines SW-27W-SW  
Lease Owner Schroff & Brown  
Lease Name Galva #1 Well No. \_\_\_\_\_  
Office Address Galva Kansas  
Character of Well (completed as Oil, Gas or Dry Hole) \_\_\_\_\_  
Date well completed 1-15-56 19\_\_\_\_  
Application for plugging filed 1-26-56 19\_\_\_\_  
Application for plugging approved \_\_\_\_\_ 19\_\_\_\_  
Plugging commenced 1-15-56 19\_\_\_\_  
Plugging completed 1-15-56 19\_\_\_\_  
Reason for abandonment of well or producing formation Dry

If a producing well is abandoned, date of last production \_\_\_\_\_ 19\_\_\_\_  
Was permission obtained from the Conservation Division or its agents before plugging was commenced? Yes

Name of Conservation Agent who supervised plugging of this well Ruel Zurbel  
Producing formation \_\_\_\_\_ Depth to top \_\_\_\_\_ Bottom \_\_\_\_\_ Total Depth of Well 354 Feet  
Show depth and thickness of all water, oil and gas formations.

OIL, GAS OR WATER RECORDS

CASING RECORD

FORMATION	CONTENT	FROM	TO	SIZE	PUT IN	PULLED OUT
				<u>8 5/8</u>	<u>177</u>	<u>None</u>

Describe in detail the manner in which the well was plugged, indicating where the mud fluid was placed and the method or methods used in introducing it into the hole. If cement or other plugs were used, state the character of same and depth placed, from \_\_\_\_\_ feet to \_\_\_\_\_ feet for each plug set.

Mud pits and circulated, Hole made  
Solid at 170', 15 sy cement thru 5 jts  
drill pipe, mud to 35', bridge,  
10 sy cement at top

1-30-56

(If additional description is necessary, use BACK of this sheet)  
Name of Plugging Contractor Mallard Drilling Co.  
Address Wichita Kansas


STATE OF Kansas COUNTY OF McPherson, ss.  
Glen R. Schroff (employee of owner) or (owner or operator) of the above-described well, being first duly sworn on oath, says: That I have knowledge of the facts, statements, and matters herein contained and the log of the above-described well as filed and that the same are true and correct. So help me God.

(Signature) Glen R. Schroff  
Galva Kansas (Address)

SUBSCRIBED AND SWORN TO before me this 20 day of January, 1956  
J. S. Inger

My commission expires July 31, 1959

Notary Public.

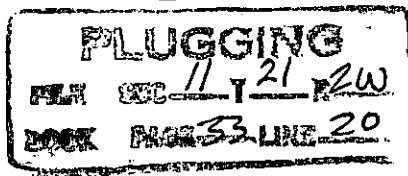

COMPANY: Tom Brown--Glenn Schroff  
 CONTRACTOR: Mallard Drilling Company  
 FARM: Galle #1  
 LOCATION: SW NW SW Sec. 11-21S-2W  
 Mc Pherson County, Kansas  
 COMMENCED: January 3, 1956  
 COMPLETED: January 15, 1956

0	to	40	Sand
40	to	175	Shale and shells
175	to	485	Shale and lime
485	to	900	Lime
900	to	1850	Lime and shale
1850	to	1970	Lime
1970	to	2308	Shale and lime
2308	to	2695	Lime
2695	to	2945	Lime and shale
2945	to	2965	Lime
2965	to	3025	Mississippi Lime
3025	to	3220	Lime
3220	to	3305	Lime and shale
3305	to	3365	Lime
3365	to	3420	Shale and lime
3420	to	3541	Sand and lime
		3541	T.D.

Set 177 feet of 8 5/8" surface pipe. Cemented with 110 sacks cement.  
 TOPS: K.G.--2307 Chat --2965 Simpson --3460 Viola -- 3419 Arbuckle -- 3525  
 Measurements taken from R.O.B. P.D.B. 5 1/2' from ground level.  
 DRY, ABANDONED AND PLUGGED

C E R T I F I C A T E

I, C. C. Nelson, do hereby certify that the above and foregoing is a true and correct copy of log of the Galle #1, Mc Pherson County, Kansas, as reflected by files of the Mallard Drilling Company.

*C. C. Nelson*

Subscribed and sworn to before me a Notary Public, within and for Sedgwick County, Kansas, this 17<sup>th</sup> day of January 1956.

*Robert A. Hurd*

My commission expires 11-16-59

**PLUGGING**  
 FILE SEC. 11 21 2W  
 BOOK PAGE 33 LINE 20