
15.113-01004-0000

STATE OF KANSAS
STATE CORPORATION COMMISSION

Give All Information Completely
Make Required Affidavit
Mail or Deliver Report to:
Conservation Division
State Corporation Commission
211 No. Broadway
Wichita, Kansas

WELL PLUGGING RECORD

NORTH

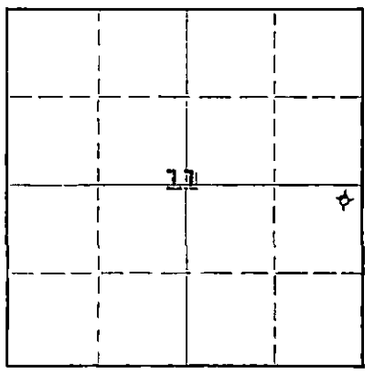

Locate well correctly on above Section Plat

McPherson County. Sec. 11 Twp. 21 Rge. (E) 2 (W)
Location as "NE/CNW¼SW¼" or footage from lines C NE NE SE
Lease Owner Donald T. Ingling
Lease Name Regier Well No. 1
Office Address Wichita 2, Kansas
Character of Well (completed as Oil, Gas or Dry Hole) Dry Hole
Date well completed November 5, 19 56
Application for plugging filed November 5, 19 56
Application for plugging approved November 5, 19 56
Plugging commenced November 5, 19 56
Plugging completed November 5, 19 56
Reason for abandonment of well or producing formation Dry

If a producing well is abandoned, date of last production 19
Was permission obtained from the Conservation Division or its agents before plugging was commenced? Yes

Name of Conservation Agent who supervised plugging of this well Ruel Durkee, McPherson, Kansas
Producing formation Depth to top Bottom Total Depth of Well 3022 Feet
Show depth and thickness of all water, oil and gas formations.

OIL, GAS OR WATER RECORDS — CASING RECORD

FORMATION	CONTENT	FROM	TO	SIZE	PUT IN	PULLED OUT
				8 5/8"	175'	None

Describe in detail the manner in which the well was plugged, indicating where the mud fluid was placed and the method or methods used in introducing it into the hole. If cement or other plugs were used, state the character of same and depth placed, from feet to feet for each plug set.

Circulated heavy mud one hour and laid down one-half drill pipe - circulated one-half hour and laid down balance of drill pipe - bottom plug at 175 feet with 15 sacks cement and top plug at 25 feet with 5 sacks

RECEIVED
STATE CORPORATION COMMISSION
NOV - 7 1956
11-7-56
CONSERVATION DIVISION
Wichita, Kansas

(If additional description is necessary, use BACK of this sheet)

Name of Plugging Contractor Donald T. Ingling
Address Wichita 2, Kansas

STATE OF KANSAS, COUNTY OF SEDGWICK, ss.
D. T. Ingling (employee of owner) or (owner or operator) of the above-described well, being first duly sworn on oath, says: That I have knowledge of the facts, statements, and matters herein contained and the log of the above-described well as filed and that the same are true and correct. So help me God.

(Signature) D. T. Ingling
623 1st Natl Bank Bldg. Wichita 2
(Address)

SUBSCRIBED AND SWORN TO before me this 5th day of November, 1956

M. E. Black
Notary Public.

My commission expires February 27, 1960

PLUGGING
FILE SEC 11 T 21 R 2W
BOOK PAGE 114 LINE 3

5441

15-113-01004-0000

WELL LOG - REGIER NO. 1

Donald T. Ingling et al, Lease Owner

Donald T. Ingling, Contractor

Commenced: 10-17-56
Completed: 11- 5-56

Total Depth: 3022'

Casing: 8 5/8" 175' (80 sacks cement)

Section 11-21-2W

Location: C NE NE SE

County: McPherson

Elevation: 1506' RB

Production: Dry

Figures below indicate bottom formation

45	surface clay and sand
80	shale
175	shale and shells
345	shale and shells
365	lime
495	lime
595	lime
715	lime
825	lime
910	lime
1095	shale and shells
1270	shale and lime streaks
1415	shale and lime
1545	shale and lime streaks
1625	shale and lime streaks
1655	lime
1755	lime
1845	lime
1945	lime
2025	lime
2085	lime
2100	lime
2240	shale and sand
2243	lime
2270	shale
2320	shale
2365	lime
2415	lime
2465	lime
2496	lime
2545	lime
2590	lime
2635	lime
2675	lime
2705	lime
2755	lime and shale
2805	lime and shale
2870	shale
2930	lime and shale
2950	shale
2972	Mississippi
2990	Mississippi
3005	Mississippi
3022	Total Depth

I certify this is a true and correct copy of the above mentioned well.

D. T. Ingling

STATE OF KANSAS)
) ss.
SEDGWICK COUNTY)

Subscribed and sworn to before me, a Notary Public, in said county and state.

M E Black

My commission expires Feb. 27, 1960

RECEIVED
STATE CORPORATION COMMISSION
NOV 7 1956
CONSERVATION DIVISION
Wichita, Kansas

PLUGGING
FILE SEC 11 T 21 R 2W
BOOK PAGE 114 LINE 3