


STATE OF KANSAS
STATE CORPORATION COMMISSION

Give All Information Completely
Make Required Affidavit
Mail or Deliver Report to:
Conservation Division
State Corporation Commission
800 Bittling Building
Wichita, Kansas

WELL PLUGGING RECORD

Pawnee County. Sec. 9 Twp. 21 Rge. 17 (E) (W)
Location as "NE/CNW $\frac{1}{4}$ SW $\frac{1}{4}$ " or footage from lines NE $\frac{1}{4}$ NE $\frac{1}{4}$ SW $\frac{1}{4}$
Lease Owner Stanolind Oil and Gas Company
Lease Name J. A. Boyd "A" Well No. 1
Office Address Box 1654, Oklahoma City, Oklahoma
Character of Well (completed as Oil, Gas or Dry Hole) Dry Hole
Date well completed 4-25-1951
Application for plugging filed 4-27-1951
Application for plugging approved 4-26-1951
Plugging commenced 4-25-1951
Plugging completed 4-25-1951
Reason for abandonment of well or producing formation Dry Hole

NORTH

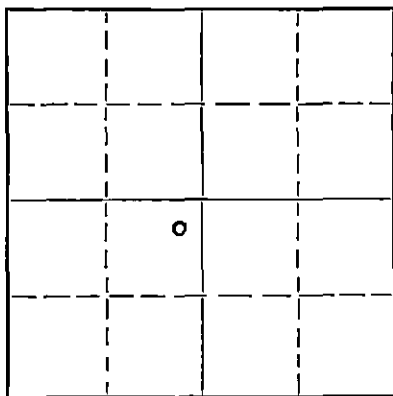

Locate well correctly on above
Section Plat

If a producing well is abandoned, date of last production _____ 19____
Was permission obtained from the Conservation Division or its agents before plugging was commenced? Yes

Name of Conservation Agent who supervised plugging of this well C. D. Stough
Producing formation Arbuckle Depth to top 3951 Bottom 3994 Total Depth of Well 3994 Feet
Show depth and thickness of all water, oil and gas formations.

OIL, GAS OR WATER RECORDS

CASING RECORD

Formation	Content	From	To	Size	Put In	Pulled Out
Arbuckle	Dry	3951	3994	8-5/8	1128	None
Lansing - K.G.	Dry	3597	3951			

Describe in detail the manner in which the well was plugged, indicating where the mud fluid was placed and the method or methods used in introducing it into the hole. If cement or other plugs were used, state the character of same and depth placed, from _____ feet to _____ feet for each plug set.

Hvy. drlg. mud 3994 - 250
15 sx cement 250 - 225
Hvy. mud 225 - 30
Capped with 30 sx cement 30' to bottom of cellar

RECEIVED
STATE CORPORATION COMMISSION
MAY 19 1951 5-19-51
CONSERVATION DIVISION
Wichita, Kansas

(If additional description is necessary, use BACK of this sheet)

Correspondence regarding this well should be addressed to G. A. Younie
Address Box 7, Ellinwood, Kansas

STATE OF Kansas, COUNTY OF Barton, ss.
W. I. Nichols (employee of owner) or (owner or operator) of the above-described well,
being first duly sworn on oath, says: That I have knowledge of the facts, statements, and matters herein contained and the log of the above-described well as filed and that the same are true and correct. So help me God.

(Signature) W. I. Nichols Prod. Foreman
Box 7, Ellinwood, Kansas
(Address)

SUBSCRIBED AND SWORN to before me this 18th day of May, 1951.

My commission expires May 2, 1955
Leuris E. Roseman Notary Public.

FILE 9 21 17W
BOOK PAGE 78 LINE 1

FORMATION RECORD

DESCRIBE EACH FORMATION DRILLED, INDICATE THICKNESS, CONTENT AND WHETHER DRY, OR OIL, GAS, OR WATER BEARING.

FORMATION	TOP	BOTTOM	FORMATION	TOP	BOTTOM
Surface Clay	0	105			
Shale	105	375			
Sand Rock - Iron	375	385			
Sand Shale	385	520			
Red Bed - Shale	520	765			
Red Bed	765	950			
Red Bed - Shells	950	1122			
Anhydrite	1122	1150			
Red Bed	1150	1420			
Shale - Shells	1420	1860			
Shale - Lime	1860	1975			
Sandy Lime	1975	2100			
Lime	2100	2265			
Sandy Lime	2265	2340			
Shale - Lime	2340	2380			
Lime	2380	2550			
Lime - Shale	2550	2680			
Shale	2680	2990			
Shale - Lime	2990	3220			
Shale	3220	3280			
Lime - Shale	3280	3345			
Lime	3345	3390			
Lime - Shale	3390	3460			
Lime	3460	3510			
Lime - Shale	3510	3597			
Top Lansing - K.C.	3597				
Lime	3597	3617			
Lime - Shale	3617	3645			
Lime - Porous - NS	3645	3725			
Lime - Shale	3725	3760			
Lime	3760	3810			
Lime - Shale	3810	3850			
Lime	3850	3900			
Conglomerate	3900	3930			
Shale	3930	3951			
Top Arbuckle	3951				
Dolomite - Fair porosity, NS	3951	3963			
Lime Dolomite, vugular	3963	3966			
Porosity Odor					
Dolomite Lime	3966	3994			
Schlumberger Electric Log to TD					
Total Depth:					
By Schlumberger		3994			
By Rotary Drill		3994			
Completed as a dry hole	4-24-51				
Plugged and abandoned	4-25-51				

PLUGGING
 FILE SEC 9-T-2-R-174
 BOOK PAGE 78 LINE 1

