

STATE OF KANSAS  
STATE CORPORATION COMMISSION


WELL PLUGGING RECORD

Give All Information Completely  
Make Required Affidavit  
Mail or Deliver Report to:  
Conservation Division  
State Corporation Commission  
212 North Market, Insurance Bldg.  
Wichita, Kansas

PAWNEE County. Sec. 9 Twp. 21S Rge. 17W (E) (W)

Location as "NE/CNW%SW%" or footage from lines C NE NE  
Lease Owner The Texaco Oil Company  
Lease Name J. A. BOYD Well No. 1  
Office Address 614 Bitting Building, Wichita, Kansas  
Character of Well (completed as Oil, Gas or Dry Hole) Dry Hole  
Date well completed 5-13-60 19  
Application for plugging filed 5-13-60 19  
Application for plugging approved 5-13-60 19  
Plugging commenced 5-13-60 19  
Plugging completed 5-13-60 19  
Reason for abandonment of well or producing formation Dry Hole

NORTH

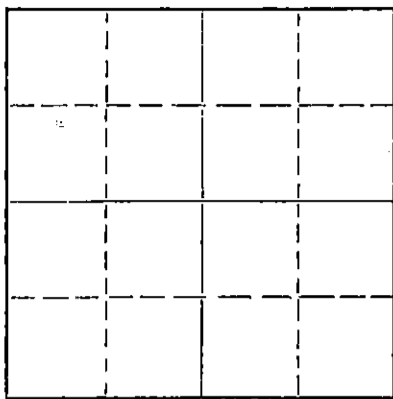

Locate well correctly on above Section Plat

If a producing well is abandoned, date of last production \_\_\_\_\_ 19\_\_\_\_  
Was permission obtained from the Conservation Division or its agents before plugging was commenced? Yes

Name of Conservation Agent who supervised plugging of this well Mr. Broadfoot, St. John, Kansas  
Producing formation \_\_\_\_\_ Depth to top \_\_\_\_\_ Bottom \_\_\_\_\_ Total Depth of Well \_\_\_\_\_ Feet  
Show depth and thickness of all water, oil and gas formations.

OIL, GAS OR WATER RECORDS

CASING RECORD

FORMATION	CONTENT	FROM	TO	SIZE	PUT IN	PULLED OUT
Red Bed	Surface Casing	-0-	852	8-5/8"	852	None

Describe in detail the manner in which the well was plugged, indicating where the mud fluid was placed and the method or methods used in introducing it into the hole. If cement or other plugs were used, state the character of same and depth placed, from \_\_\_\_\_ feet to \_\_\_\_\_ feet for each plug set.

PLUGGED: Filled hole with heavy mud 4025' up to 300'. Built bridge using 1/3 sk. hulls, wood plug, 20 sx. cement through drill pipe. Filled hole with mud up to 35', 1/2 sk. hulls, wood plug, 10 sx. cement to cellar zero.

Job Completed: 8 p.m. - 5-13-60

RECEIVED  
STATE CORPORATION COMMISSION  
MAY 17 1960  
CONSERVATION DIVISION  
Wichita, Kansas

(If additional description is necessary, use BACK of this sheet)  
Name of Plugging Contractor Sierra Petroleum Co., inc.  
Address 208 Petroleum Building, Wichita, Kansas

STATE OF KANSAS, COUNTY OF RUSSELL, ss.  
C. T. HONAKER (employee of owner) or (owner or operator) of the above-described well, being first duly sworn on oath, says: That I have knowledge of the facts, statements, and matters herein contained and the log of the above-described well as filed and that the same are true and correct. So help me God.

(Signature) C. T. Honaker C. T. HONAKER, DRUG. SUPT.

Box 232, Russell, Kansas  
(Address)

SUBSCRIBED AND SWORN TO before me this 16th day of MAY, 19 60

My commission expires 10-17-63

Jeroy Bily  
Notary Public.

THE TEXACO OIL COMPANY - - - Operator  
SIERRA PETROIEUM CO., INC. - Contractor

Elevation: 2089' K.B.  
T. D. : 4025'

J. A. BOYD #1  
C NE NE - Sec. 9-21S-17W  
Pawnee County, Kansas

Commenced: 4-27-60  
Completed: 5-13-60

CASING:

8-5/8" Set at 852'

CEMENT:

with 400 sacks

FORMATION	DEPTH
Surface Clay & Sand	70
Shale	535
Sndy Pyrite	670
Shale & Red Bed	842
Red Bed	1110
Anhydrite	1138
Red Bed	1235
Shale	1375
Shale & Salt	1710
Shale & Shells	1925
Lime & Shale	2755
Lime	2830
Shale & Lime	3274
Lime	3422
Lime & Shale	3464
Lime	4016
Arbuckle	4025
TOPS: Arbuckle	3966

RECEIVED  
STATE CORPORATION COMMISSION

MAY 17 1960

CONSERVATION DIVISION  
Wichita, Kansas

STATE OF KANSAS )  
                          ) ss:  
COUNTY OF RUSSELL )

I hereby certify that the above information is true and correct to the best of my knowledge.

C. P. Henaker

Subscribed and sworn to before me this 16th day of May 1960.

Lesay A. [Signature]  
Notary Public

My commission expires: 10-17-63

