


Give All Information Completely
Make Required Affidavit

Mail or Deliver Report to:
Conservation Division
State Corporation Commission
212 North Market, Insurance Bldg.
Wichita, Kansas

WELL PLUGGING RECORD

Pawnee County, Sec. 9 Twp. 21S Rge. 17W (W)

Location as "NE/CNW%SW%" or footage from lines C NE NE
Lease Owner Texaco Inc.
Lease Name J. A. Boyd Well No. 1
Office Address 614 Bitting Bldg., Wichita, Kansas
Character of Well (completed as Oil, Gas or Dry Hole) Dry Hole
Date well completed May 13, 19 60
Application for plugging filed May 13, 19 60
Application for plugging approved May 17, (Verbal) 19 60
Plugging commenced May 13, 5-13-60) 19 60
Plugging completed May 14, 19 60
Reason for abandonment of well or producing formation --

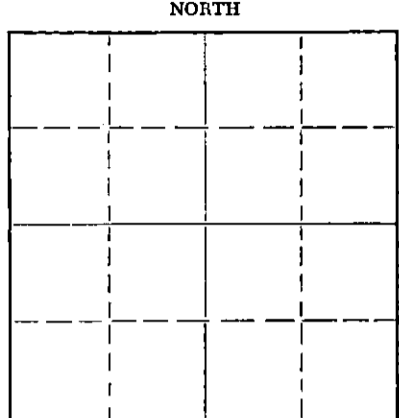

Locate well correctly on above Section Plat

If a producing well is abandoned, date of last production --- 19---
Was permission obtained from the Conservation Division or its agents before plugging was commenced? Yes

Name of Conservation Agent who supervised plugging of this well Broadfoot
Producing formation -- Depth to top --- Bottom --- Total Depth of Well 4025 Feet
Show depth and thickness of all water, oil and gas formations.

OIL, GAS OR WATER RECORDS

CASING RECORD

FORMATION	CONTENT	FROM	TO	SIZE	PUT IN	PULLED OUT
				8-5/8	863	0

Describe in detail the manner in which the well was plugged, indicating where the mud fluid was placed and the method or methods used in introducing it into the hole. If cement or other plugs were used, state the character of same and depth placed, from --- feet to --- feet for each plug set.

PLUGGED AS FOLLOWS:

4025 to 300 heavy mud,
20 sx cement plug at 300',
Mud to 35',
35' to bottom of cellar, 10 sx cement

RECEIVED
STATE CORPORATION COMMISSION
MAY 27 1960
CONSERVATION DIVISION
Wichita, Kansas

(If additional description is necessary, use BACK of this sheet)
Name of Plugging Contractor Sierra Petroleum Company, Inc.
Address 208 Petroleum Bldg., Wichita, Kansas

STATE OF Kansas, COUNTY OF Sedgwick, ss.
--- (employee of owner) or (owner or operator) of the above-described well, being first duly sworn on oath, says: That I have knowledge of the facts, statements, and matters herein contained and the log of the above-described well as filed and that the same are true and correct. So help me God.

(Signature) M. H. Hurrell
614 Bitting Bldg., Wichita, Kansas
(Address)

SUBSCRIBED AND SWORN TO before me this 25th day of May, 19 60
H. Howard Kistler
Notary Public.

My commission expires Sept. 20, 1960



TEXACO INC.—LOG OF WELL
Tulsa DIVISION

640 ACRES
N

INDICATE EXACT WELL LOCATION & LEASE BOUNDARY WITHIN SECTION

WELL J. A. Boyd #1 L. D. FILE NO. 197416

LOC. C NE NE SEC. 9 TWP. 21S RGE. 17W

Staked 660' west & 660' South of NE Corner of NE/4

DIST. Wichita CO., PARISH Pawnee STATE Kansas

COMM. DRLG. 4/27/60 COMP. DRLG. 5/13/60 DAYS DRLG. 17

ROT. FROM 0 TO 4025 CABLE FROM --- TO ---

CONTR. OR CO, RIG NO. Sierra Pot. Co. Inc. T. D. DRILLED 4025

COMP. T. D. 4025 ZERO ELEV. -- GRD. ELEV. -- CSG. FLG. ELEV. --

DATE OF FIRST PROD. Dry Hole OFFICIAL COMP. DATE 5-14-60

LOGS RUN Sonic

CASING RECORD

SIZE INCHES	DEPTH FEET	WEIGHT #/FT.	GRADE	RANGE	REMARKS—QUAN. CMT., TEMP. SURV., ETC.
<u>8-5/8</u>	<u>863</u>	<u>24^{1/2}</u>	<u>J</u>		<u>Set at 852' w/400 sx Pozmix & 2 1/2 cc, cement circulated.</u>

COMPLETION DATA

FORMATION	<u>DRY HOLE</u>		
DATE OF TEST			RECEIVED
DEPTH OF PROD. INTERVAL			STATE COMPLETION COMMISSION
INITIAL PRODUCTION: OIL - BPD			<u>MAY 27 1960</u>
GAS - MCF			CONSERVATION DIVISION
WATER - BPD			Wichita, Kan.
GOR			
BHP - PSI			
CORRECTED API GRAVITY			
PRODUCING CONDITIONS			
ARTIFICIAL STIMULATION			

REMARKS

WELL J. A. Boyd #1 FIELD Wildcat AREA Great Bend

THE TEXACO OIL COMPANY - - - Operator
 SIERRA PETROLEUM CO., INC. - Contractor

Elevation: 2069' K.B.
 T. D. : 4025'

J. A. BOYD #1
 C NE NE - Sec. 9-21S-17W
 Pawnee County, Kansas

Commenced: 4-27-60
 Completed: 5-13-60

CASING:

8-5/8" Set at 352'

CEMENT:

with 400 sacks

FORMATION	DEPTH
Surface Clay & Sand	70
Shale	530
Sndy Pyrite	670
Shale & Red Bed	842
Red Bed	1110
Anhydrite	1130
Red Bed	1235
Shale	1375
Shale & Salt	1710
Shale & Shells	1925
Lime & Shale	2755
Lime	2830
Shale & Lime	3274
Lime	3422
Lime & Shale	3464
Lime	4016
Arbuckle	4025

TOPS: Arbuckle

3956

RECEIVED
 STATE CORPORATION COMMISSION
 MAY 27 1960
 CONSERVATION DIVISION
 Wichita, Kansas

STATE OF KANSAS)
) ss:
 COUNTY OF RUSSELL)

I hereby certify that the above information is true and correct to the best of my knowledge.

C. T. Anderson

Subscribed and sworn to before me this 16th day of May 1960.

Geray Drey
 Notary Public

My commission expires: 10-17-63