


STATE OF KANSAS
STATE CORPORATION COMMISSION

Form CP-4

Give All Information Completely
Make Required Affidavit
Mail or Deliver Report to:
Conservation Division
State Corporation Commission
211 No. Broadway
Wichita, Kansas

WELL PLUGGING RECORD

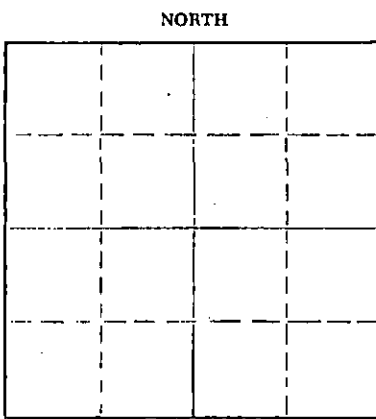

Pawnee County, Sec. 9 Twp. 21 Rge. (E) 17 (W)
Location as "NE/CNW&SW¼" or footage from lines C NW NW
Lease Owner Woodman & Iannitti Drilling Co.
Lease Name Boyd Well No. 1
Office Address 706 Union Nat'l. Bldg. Wichita, Kansas
Character of Well (completed as Oil, Gas or Dry Hole) Dry Hole
Date well completed 6-13 19 64
Application for plugging filed 6-13 19 64
Application for plugging approved 6-13 19 64
Plugging commenced 6-13 19 64
Plugging completed 6-13 19 64
Reason for abandonment of well or producing formation Dry

If a producing well is abandoned, date of last production 19
Was permission obtained from the Conservation Division or its agents before plugging was commenced? Yes

Name of Conservation Agent who supervised plugging of this well Eldon Petty
Producing formation _____ Depth to top _____ Bottom _____ Total Depth of Well 4100 Feet
Show depth and thickness of all water, oil and gas formations.

OIL, GAS OR WATER RECORDS

CASING RECORD

FORMATION	CONTENT	FROM	TO	SIZE	PUT IN	PULLED OUT
				8 5/8	175'	

Describe in detail the manner in which the well was plugged, indicating where the mud fluid was placed and the method or methods used in introducing it into the hole. If cement or other plugs were used, state the character of same and depth placed, from _____ feet to _____ feet for each plug set.

Bottom Plug @ 480' w/ 20 sx cement
Middle Plug @ 240' w/ 20 sx. cement
Top Plug @ 40' w/ 10 sx cement

RECEIVED
STATE CORPORATION COMMISSION

JUL 17 1964

CONSERVATION DIVISION
Wichita, Kansas

7-17-64

(If additional description is necessary, use BACK of this sheet)
Name of Plugging Contractor Woodman & Iannitti Drilling Co.
Address 706 Union National Building, Wichita, Kansas

STATE OF Kansas, COUNTY OF Sedgwick, ss.
K. T. Woodman (employee of owner) or (owner or operator) of the above-described

well, being first duly sworn on oath, says: That I have knowledge of the facts, statements, and matters herein contained and the log of the above-described well as filed and that the same are true and correct. So help me God.

(Signature) K. T. Woodman

706 Union National Bldg.
(Address)

SUBSCRIBED AND SWORN to before me this 16 day of July, 19 64

My commission expires Feb. 11, 1968

Justin Chamberlain
Notary Public.

DRILLING LOG

Company: Woodman & Iannitti Drilling Co.
 #1 Boyd
 Sec. 9 -21-17W
 C NW NW, Pawnee County, Kansas

Contractor: Woodman & Iannitti Drilling Co.
 706 Union Nat'l. Bldg.
 Wichita, Kansas.

Date Comm: June 2, 1964

Date Comp: June 13, 1964

Total Depth: 4100'

Casing: 8 5/8 @ 275' W/175 ex. cement

D & A
 Figures indicate the bottom of the formation

0	55	Clay
55	225	Post Rock Clay
225	240	Clay
240	279	Clay & Red Bed
279	475	Shale
475	575	Red Bed & Shale
575	695	Sand
695	1151	Red Bed
1151	1180	Anhy.
1180	1350	Red Bed Shale
1350	1500	Shale
1500	1510	Shale & Shells
1510	1980	Shale & Shells
1980	2152	Lime & Shale
2152	2260	Lime
2260	2368	Lime
2368	2485	Lime
2485	2600	Lime
2600	2750	Lime & Shale
2750	2890	Lime & Shale
2890	3055	Shale & Lime
3055	3163	Lime & Shale
3163	3270	Lime
3270	3365	Lime
3365	3421	Lime
3421	3485	Lime
3485	3545	Lime
3545	3611	Lime
3611	3665	Lime
3665	3730	Lime
3730	3765	Lime
3765	3825	Lime
3825	3870	Lime
3870	3905	Lime
3905	3955	Lime
3955	3996	Lime
3996	4003	Arb.
4003	4010	Arb.
4010	4045	Lime & Chert.
4045	4082	Arb. Chert.
4082	4100	Arb.
4100		Total Depth

RECEIVED
 STATE CORPORATION COMMISSION

JUN 16 1964

CONSERVATION DIVISION
 Wichita, Kansas

I certify the above to be a true and correct copy of the Drillers Log and the Geological logs to the best of my knowledge and belief.

WOODMAN & IANNITTI DRILLING COMPANY

By: K. T. Woodman
 K. T. Woodman

WELL PLUGGING RECORD

County; Pawnee
 Location: C NW NW
 Section: 9-21-17W
 Lease Owner: Woodman & Iannitti Drilling Co.
 Lease Name: #1 Boyd
 Office Address: 706 Union National Building
 Character of Well: Dry Hole
 Date Well Completed: June 13, 1964
 Application for Plugging Filed: June 13, 1964
 Application for plugging approved: June 13, 1964
 Plugging Commenced: June 13, 1964
 Plugging Completed: June 13, 1964
 Reason for Abandonment of Well: Dry
 Was Permission Obtained: yes
 Name of Conservation Agent: Eldon Petty
 Total Depth of Well 4100'

RECEIVED
STATE CORPORATION COMMISSION

JUN 16 1964

CONSERVATION DIVISION
Wichita, Kansas

Casing Record: 8 5/8 @ 175'

Plugg in
 Plugging Record: Bottom Plug @ 480' w/ 20 sz. cement
 Middle Plug @ 240' w/ 20 sz. cement
 Top Plug @ 40' w/ 10 sz. cement

Name of Plugging Contractor: Woodman & Iannitti Drilling Company
706 Union National Building

STATE OF KANSAS, COUNTY OF SEDGWICK, ss.

K. T. Woodman co-owner of the above described well, being first duly sworn on oath, says: That I have knowledge of the facts, statements, and matters herein contained and the log of the above described well as filed and that the same are true and correct. So help me God.

K. T. Woodman
 706 Union National Building

Subscribed and Sworn to before me this 15, day of June 1964

Justina Chamberlain
 Justina Chamberlain Notary Public.

My commission expires Feb. 11, 1968