

STATE OF KANSAS
STATE CORPORATION COMMISSION


Form CP-4

Give All Information Completely
Make Required Affidavit
Mail or Deliver Report to:
Conservation Division
State Corporation Commission

WELL PLUGGING RECORD

P. O. Box 17027
Wichita, Kansas 67217
NORTH

Pawnee County, Sec. 9 Twp. 21S Rge. (E) 17 (W)
Location as "NE/CNW/SW" or footage from lines G S/2 S/2
Lease Owner National Oil Company
Lease Name Boyd Well No. 1
Office Address 200 W. Douglas, Suite 550, Wichita, Kansas
Character of Well (completed as Oil, Gas or Dry Hole) Dry Hole
Date well completed Feb. 12 1975
Application for plugging filed Feb. 12 1975
Application for plugging approved Feb. 12 1975
Plugging commenced Feb. 12 1975
Plugging completed Feb. 12 1975
Reason for abandonment of well or producing formation Dry Hole

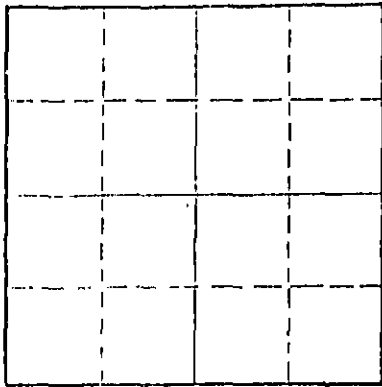

Locate well correctly on above
Section Plat

If a producing well is abandoned, date of last production 19
Was permission obtained from the Conservation Division or its agents before plugging was commenced? Yes

Name of Conservation Agent who supervised plugging of this well Leo F. Massey
Producing formation _____ Depth to top _____ Bottom _____ Total Depth of Well 4000 Feet
Show depth and thickness of all water, oil and gas formations.

OIL, GAS OR WATER RECORDS

CASING RECORD

FORMATION	CONTENT	FROM	TO	SIZE	PUT IN	PULLED OUT
				8 5/8	194'	

Describe in detail the manner in which the well was plugged, indicating where the mud fluid was placed and the method or methods used in introducing it into the hole. If cement or other plugs were used, state the character of same and depth placed, from _____ feet to _____ feet for each plug set.

420' w/50 sx.
185' w/25 sx.
40' w/10 sx.

RECEIVED
STATE CORPORATION COMMISSION

RECEIVED
STATE CORPORATION COMMISSION

FEB 18 1975
CONSERVATION DIVISION
Wichita, Kansas

FEB 18 1975
CONSERVATION DIVISION
Wichita, Kansas

(If additional description is necessary, use BACK of this sheet)
Name of Plugging Contractor Woodman & Iannitti Drilling Co.
Address 1008 Union National Bldg.

STATE OF KANSAS, COUNTY OF SEDGWICK, ss.
K. T. Woodman (employee of owner) or (owner or operator) of the above-described

well, being first duly sworn on oath, says: That I have knowledge of the facts, statements, and matters herein contained and the log of the above-described well as filed and that the same are true and correct. So help me God.

(Signature) K. T. Woodman
1008 Union National Bldg.
(Address)

Subscribed and Sworn to before me this 12th day of February, 1975

My commission expires Feb. 11, 1976
Justina Chamberlain Notary Public.

K. F. WOODMAN
RES. PHONE 733-0418
OFF. PHONE 265-7650
WICHITA, KANSAS

15.145.20361.0000

D. J. IANNITTI
PHONE 792-2921
GREAT BEND, KANSAS

WOODMAN & IANNITTI DRILLING COMPANY
Rotary Drilling Contractors

1008 UNION NATIONAL BUILDING
WICHITA, KANSAS 67202

February 13, 1975

Company;	National Oil Company
Farm;	#1 Boyd
Location;	C S/2 S/2
Section;	9-21S-17W
County;	Pawnee
Contractor;	Woodman & Iannitti Drilling Co.
Comm;	January 31, 1975
Compl;	February 12, 1975
Total Depth;	4000'
Casing;	8 5/8" @ 194 w/175 sx.
Production;	D & A

Figures Indicate Bottom Of Formations:

40	Surface soil
80	Clay
195	Shale & Sand Streaks
355	Shale
550	Shale
675	Sand
1128	Red Bed
1152	Anhy
1550	Shale
1680	Shale & Shells
2095	Lime & Shale
2420	Lime & Shale
2510	Shale & Lime
2700	Lime
3055	Lime & Shale
3350	Lime
3565	Lime
3757	Lime
3900	Lime
4000	Lime

RECEIVED
STATE CORPORATION COMMISSION

FEB 14 1975

CONSERVATION DIVISION
Wichita, Kansas

I certify the above to be a true and correct copy of the driller's log to the best of my knowledge and belief.

Woodman & Iannitti Drilling Co.

K. T. Woodman

K. T. Woodman