

WELL PLUGGING RECORD

Give All Information Completely
Make Required Affidavit
Mail or Deliver Report to:
Conservation Division
State Corporation Commission
211 No. Broadway
Wichita, Kansas

Stafford County. Sec. 20 Twp. 23 Rge. 14 (E) (W)

Location as "NE/CNW/SW" or footage from lines SW 1/4 NE 1/4 NE 1/4

Lease Owner Barnett Drilling, Inc.

Lease Name Cornwell Well No. 1

Office Address 409 First National Bank Building, Wichita 2, Kansas

Character of Well (completed as Oil, Gas or Dry Hole) Dry hole

Date well completed December 16 1956

Application for plugging filed December 16 1956

Application for plugging approved December 16 1956


Plugging commenced December 16 1956

Plugging completed December 16 1956

Reason for abandonment of well or producing formation Dry hole

If a producing well is abandoned, date of last production _____ 19____

Was permission obtained from the Conservation Division or its agents before plugging was commenced? Yes

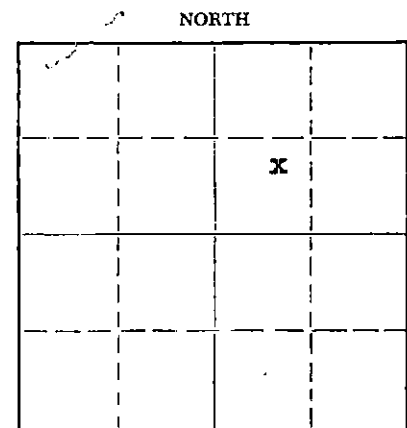

Locate well correctly on above Section Plat

Name of Conservation Agent who supervised plugging of this well R. M. Brundege

Producing formation _____ Depth to top _____ Bottom _____ Total Depth of Well 4064 Feet

Show depth and thickness of all water, oil and gas formations.

OIL, GAS OR WATER RECORDS

CASING RECORD

FORMATION	CONTENT	FROM	TO	SIZE	PUT IN	PULLED OUT

Describe in detail the manner in which the well was plugged, indicating where the mud fluid was placed and the method or methods used in introducing it into the hole. If cement or other plugs were used, state the character of same and depth placed, from _____ feet to _____ feet for each plug set.

Filled hole with heavy mud from 4064 feet to 210 feet. Set plug at 210 feet. Dumped 1/2 sack of hulls and 20 sacks of cement on plug and completed filling hole with heavy mud to 35 feet. Set second plug at 35 feet, dumped 1/2 sack of hulls and 10 sacks of cement on plug.

RECEIVED
STATE CORPORATION COMMISSION
DEC 20 1956
CONSERVATION DIVISION
Wichita, Kansas

12-20-56

(If additional description is necessary, use BACK of this sheet)

Name of Plugging Contractor Barnett Drilling, Inc.
Address 409 First National Bank Bldg., Wichita, Kansas

STATE OF Kansas, COUNTY OF Sedgwick, ss.
F. R. Stubblefield (employee of owner) or (owner or operator) of the above-described

well, being first duly sworn on oath, says: That I have knowledge of the facts, statements, and matters herein contained and the log of the above-described well as filed and that the same are true and correct. So help me God.

(Signature) F. R. Stubblefield
Wichita, Kansas (Address)

SUBSCRIBED AND SWORN TO before me this 19th day of December, 19 56

Mildred F. Willis
Notary Public.

My commission expires February 27, 1960

PLUGGING
FILE SEC 20 T 23 R 14 W
BOOK PAGE 126 LI E 36

Fidelity Union Skin

BARNETT DRILLING, INC.
LOG OF CORNWELL WELL NO. 1
SW 1/4 NE 1/4 NE 1/4 SECTION 20-23-14W
STAFFORD COUNTY, KANSAS.

15-185-00911-0000

Commenced: 12-6-'56

Completed: 12-16-'56

<u>Formation</u>	<u>From</u>	<u>To</u>	<u>Remarks</u>
Sand	-0-	120	Set 8-5/8" Casing at 226 feet; Cemented with 175 sacks.
Shale and Shells	120	226	
Shale and Shells	226	540	
Red Bed	540	765	
Sandy Shale	765	805	
Shale	805	880	
Anhydrite	880	910	
Shale and Shells	910	1585	
Shale	1585	1830	
Lime and Shale	1830	1965	
Lime	1965	2620	
Lime and Shale	2620	3280	
Lime	3280	3390	
Lime and Shale	3390	3550	
Lime	3550	3835	
Lime and Shale	3835	3900	
Lime	3900	3950	
Lime and Chert	3950	3990	
Lime	3990	4064	
Total Depth		4064	Plugged and abandoned.

CERTIFICATE

I, F. R. Stubblefield of Barnett Drilling, Inc. certify to the best of my knowledge and belief, that the foregoing is a true and correct log of the Cornwell Well No. 1, located in the SW NE NE of Section 20-23-14W, Stafford County, Kansas.

F. R. Stubblefield

Subscribed and sworn to by and before me in and for the County of Sedgwick, State of Kansas this 19th day of December, 1956.

Mildred F. Willis

My commission expires February 27, 1960.



REC'D
STATE CORP
DEC 20 1956
CONSERVATION DIVISION
Wichita, Kansas

Fidelity Union Skin
MADE IN U.S.A.

PLUGGING
FILE NO. SEC 20 T. 23 R. 14 W
BOOK PAGE 126 LINE 36