

CARD MUST BE TYPED

State of Kansas

NOTICE OF INTENTION TO DRILL

CARD MUST BE SIGNED

CORRECTION

4-16-87

(see rules on reverse side)

Starting Date 3 10 87
month day year

API Number 15- 185- 22, 422-0000
50' So. of 100' E. of _____ East
NE NW SW Sec. 13 Twp. 23 S, Rg. 14 X West
X 2260' Ft. from South Line of Section
4190' Ft. from East Line of Section

OPERATOR: License # 04959
Name ZPC Petroleum, Inc.
Address 9319 E. Harry, Suite 122
City/State/Zip Wichita, Kansas 67207
Contact Person Patrick J. Deenihan
Phone (316) 683-8838

(Note: Locate well on Section Plat on reverse side)
Nearest lease or unit boundary line 380' feet
County Stafford
Lease Name McCandless Well # 1
Ground surface elevation 1929' feet MSL
Domestic well within 330 feet: X yes ___ no
Municipal well within one mile: ___ yes X no
Depth to bottom of fresh water 100' feet
Depth to bottom of usable water 225' feet

CONTRACTOR: License # 5302
Name Red Tiger Drilling Company
City/State Wichita, Kansas

Well Drilled For: Well Class: Type Equipment:
X Oil ___ SWD ___ Infield X Mud Rotary
___ Gas ___ Inj ___ Pool Ext. ___ Air Rotary
___ OWWO ___ Expl X Wildcat ___ Cable

Surface pipe by Alternate: 1 X 2
Surface pipe planned to be set 8 5/8, 20# at 250' feet
Conductor pipe required None
Projected Total Depth 4100' feet
Formation Arbuckle

If OWWO: old well info as follows:

Operator
Well Name
Comp Date Old Total Depth

I certify that well will comply with K.S.A. 55-101, et seq., plus eventually plugging hole to KCC specifications.

Date 4-14-87 Signature of Operator or Agent [Signature] Title President

For KCC Use:

Conductor Pipe Required feet; Minimum Surface Pipe Required 245 feet per Alt. ① X


This Authorization Expires 9-5-87 Approved By 3-5-87

Must be filed with the K.C.C. five (5) days prior to commencing well
This card void if drilling not started within six (6) months of date received by K.C.C.

Important procedures to follow:

1. Notify District office before setting surface casing.
2. Set surface casing by circulating cement to the top.
3. File completion forms ACO-1 with K.C.C. within 90 days of well completion, following instructions on ACO-1, side 1, and including copies of wireline logs.
4. Notify District office 48 hours prior to old well workover or re-entry.
5. Prior to filing Intent, prepare a proposed plugging plan in case well is abandoned & A, then obtain approval of plan when calling district office prior to setting surface pipe.
6. Submit plugging report (CP-4) to K.C.C. after plugging is completed.
7. Obtain an approved injection docket number before disposing of salt water.
8. Notify K.C.C. within 10 days when injection commences or terminates.
9. If an alternate 2 completion, cement in the production pipe from below any usable water to surface within 120 days of spud date.

**A Regular Section of Land
1 Mile = 5,280 Ft.**

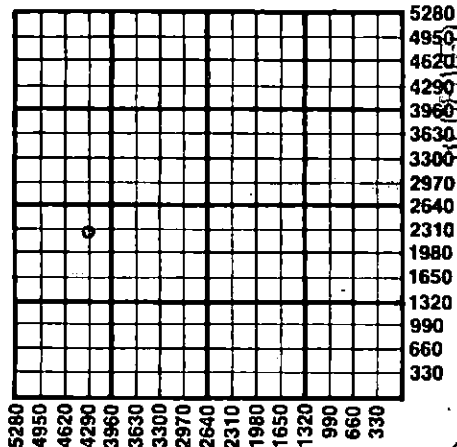

STATE CORPORATION COMMISSION

APR 16 1987

CONSERVATION DIVISION
Wichita, Kansas

4-16-87

State Corporation Commission of Kansas
Conservation Division
200 Colorado Derby Building
Wichita, Kansas 67202
(316) 263-3238