

CARD MUST BE TYPED

State of Kansas  
NOTICE OF INTENTION TO DRILL  
(see rules on reverse side)

SPOT CORRECTION CHANGE

11-9-84 CARD MUST BE SIGNED

Starting Date: 11 month 14 day 84 year

API Number 15- 009-23,758-00-00

OPERATOR: License # 5770  
Name Reif Oil Operations Inc.  
Address Box 298  
City/State/Zip Hoisington, Kansas 67544  
Contact Person Don Reif  
Phone 316-653-7745

\* C. S. 1/2 S. 1/2 SE Sec 9 Twp 16. S, Rge 12.  East  West  
(location)

330 Ft North from Southeast Corner of Section

\* 1320 Ft West from Southeast Corner of Section  
(Note: Locate well on Section Plat on reverse side)

CONTRACTOR: License # 5671  
Name Revlin Drlg., Inc.  
City/State Box 293 Russell, Ks. 67665

Nearest lease or unit boundary line 330 feet.

County Barton

Lease Name Carl Staudinger Well# 1

Domestic well within 330 feet:  yes  no

Municipal well within one mile:  yes  no

Well Drilled For: Well Class: Type Equipment:  
 Oil  Swd  Infield  Mud Rotary  
 Gas  Inj  Pool Ext.  Air Rotary  
 OWWO  Expl  Wildcat  Cable

Depth to Bottom of fresh water 265 feet

Lowest usable water formation Dakota

Depth to Bottom of usable water 400 feet

Surface pipe by Alternate: 1  2

Surface pipe to be set 800 feet

Conductor pipe if any required feet

Ground surface elevation feet MSL

This Authorization Expires 4-18-85

Approved By 12-18-84

If OWWO: old well info as follows:

Operator  
Well Name  
Comp Date Old Total Depth  
Projected Total Depth 3400 feet  
Projected Formation at TD  
Expected Producing Formations

I certify that we will comply with K.S.A. 55-101, et seq., plus eventually plugging hole to K.C.C. specifications was.

S.W. S.E. S.E.  
990 FEL

Date 11-7-84 Signature of Operator or Agent


Paula J. Gibson

Title Agent

Must be filed with the K.C.C. five (5) days prior to commencing well  
This card void if drilling not started within six (6) months of date received by K.C.C.

**Important procedures to follow:**

**A Regular Section of Land**  
**1 Mile = 5,280 Ft.**

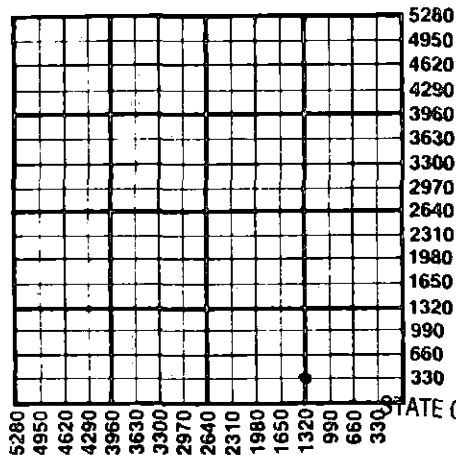

1. Notify District office before setting surface casing.
2. Set surface casing by circulating cement to the top.
3. File completion forms ACO-1 with K.C.C. within 90 days of well completion, following instructions on ACO-1, side 1, and including copies of wireline logs.
4. Notify District office 48 hours prior to old well workover or re-entry.
5. Prior to plugging, prepare a plugging plan, then obtain agreement from the appropriate district office for an approved plugging plan.
6. Submit plugging report (CP-4) to K.C.C. after plugging is completed.
7. Obtain an approved injection docket number before disposing of salt water.
8. Notify K.C.C. within 10 days when injection commences or terminates.
9. If an alternate 2 completion, cement in the production pipe from below any usable water to surface within 120 days of spud date.

RECEIVED

STATE CORPORATION COMMISSION

State Corporation Commission of Kansas

Conservation Division

200 Colorado Derby Building

Wichita, Kansas 67202

(316) 263-3238

NOV 08 1984

CONSERVATION DIVISION  
Wichita, Kansas