

CARD MUST BE TYPED

State of Kansas  
**NOTICE OF INTENTION TO DRILL**

CARD MUST BE SIGNED

(see rules on reverse side)

1885

Starting Date: March 2 1985  
month day year

API Number 15- 009-23,887 0000

OPERATOR: License # 6039  
Name L. D. Drilling, Inc. ~~L. D. Davis~~  
Address R.R. 1 Box 183 B  
City/State/Zip Great Bend, Ks. 67530  
Contact Person L. D. Davis  
Phone 316-793-3051

NE NE SW Sec 8 Twp 16 S, Rge 12  East  
(location)  West

2310 Ft North from Southeast Corner of Section  
2970 Ft West from Southeast Corner of Section  
(Note: Locate well on Section Plat on reverse side)

CONTRACTOR: License #  
Name Company Tools  
City/State

Nearest lease or unit boundary line 330 feet.  
County BARTON  
Lease Name LUERMAN Well# 2

Well Drilled For: Well Class: Type Equipment:  
 Oil  Swd  Infield  Mud Rotary  
 Gas  Inj  Pool Ext.  Air Rotary  
 OWWO  Expl  Wildcat  Cable

Domestic well within 330 feet:  yes  no  
Municipal well within one mile:  yes  no

If OWWO: old well info as follows:

Depth to Bottom of fresh water 253 feet  
Lowest usable water formation Dakota  
Depth to Bottom of usable water 350 feet

Surface pipe by Alternate: 1  2   
Surface pipe to be set app 300 350 mtc feet

Conductor pipe if any required none feet  
Ground surface elevation applies for feet MSL

This Authorization Expires 8-19-85  
Approved By L.D. Davis

I certify that we will comply with K.S.A. 55-101, et seq., plus eventually plugging hole to K.C.C. specifications.


Date 2-18-84 Signature of Operator or Agent L. D. Davis Title Operator

mtc/WOHE 2-19-85  
Form C-1 4/84

Must be filed with the K.C.C. five (5) days prior to commencing well  
 This card void if drilling not started within six (6) months of date received by K.C.C.

**Important procedures to follow:**

**A Regular Section of Land  
 1 Mile = 5,280 Ft.**

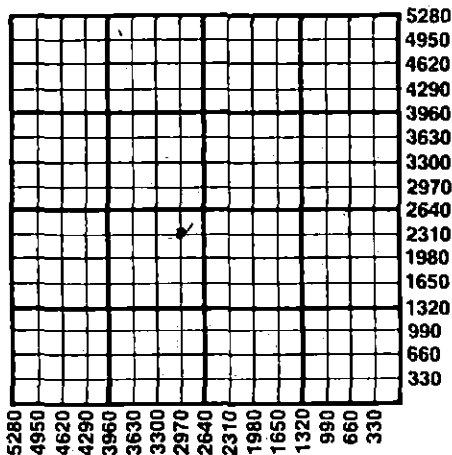

1. Notify District office before setting surface casing.
2. Set surface casing by circulating cement to the top.
3. File completion forms ACO-1 with K.C.C. within 90 days of well completion, following instructions on ACO-1, side 1, and including copies of wireline logs.
4. Notify District office 48 hours prior to old well workover or re-entry.
5. Prior to plugging, prepare a plugging plan and obtain agreement from the appropriate district office for an approved plugging plan.
6. Submit plugging report (CP-4) to K.C.C. after plugging is completed.
7. Obtain an approved injection number before disposing of salt water.
8. Notify K.C.C. within 10 days when injection commences or terminates.
9. If an alternate 2 completion, cement in the production pipe from below any usable water to surface within 120 days of spud date.

STATE CORPORATION COMMISSION  
 FEB 19 1985  
 CONSERVATION DIVISION  
 Wichita, Kansas

State Corporation Commission of Kansas  
 Conservation Division  
 200 Colorado Derby Building  
 Wichita, Kansas 67202  
 (316) 263-3238

and  
 02-19-85