

CARD MUST BE TYPED

State of Kansas
NOTICE OF INTENTION TO DRILL
(see rules on reverse side)

SPOT LOCATION CORRECTION

10-28-84
CARD MUST BE SIGNED

Starting Date: 10 30 84
month day year

API Number 15- 009-23,760 0000

OPERATOR: License # 5770
Name Reif Oil Operations Inc.
Address Box 298
City/State/Zip Hoisington, Kansas 67544
Contact Person Don Reif
Phone 316-653-7745

K.C. SW NE Sec 8 Twp 16 S, Rge 12
(location) East West

* 3300 Ft North from Southeast Corner of Section
* 1980 Ft West from Southeast Corner of Section
(Note: Locate well on Section Plat on reverse side)

CONTRACTOR: License # 5671
Name Revlin Drlg., Inc.
City/State Box 293 Russell, Ks. 67665

Nearest lease or unit boundary line 330 feet.
County Barton
Lease Name Bieberle Well # 2

Well Drilled For: Well Class: Type Equipment:
 Oil Swd Infield Mud Rotary
 Gas Inj Pool Ext. Air Rotary
 OWWO Expl Wildcat Cable

Domestic well within 330 feet: yes no
Municipal well within one mile: yes no

If OWWO: old well info as follows:

Operator
Well Name
Comp Date Old Total Depth
Projected Total Depth 3360 feet
Projected Formation at TD
Expected Producing Formations

Depth to Bottom of fresh water 250 feet
Lowest usable water formation Dakota
Depth to Bottom of usable water 400 feet
Surface pipe by Alternate: 1 2
Surface pipe to be set 800 feet
Conductor pipe if any required feet
Ground surface elevation feet MSL
This Authorization Expires 4-18-85
Approved By 10-18-84
Kwas SW SE NE

I certify that we will comply with K.S.A. 55-101, et seq., plus eventually plugging hole to K.C.C. specifications.

Date 10-23-84 Signature of Operator or Agent


Paula J. Gibson

Title Agent

Must be filed with the K.C.C. five (5) days prior to commencing well
 This card void if drilling not started within six (6) months of date received by K.C.C.

Important procedures to follow :

**A Regular Section of Land
 1 Mile = 5,280 Ft.**

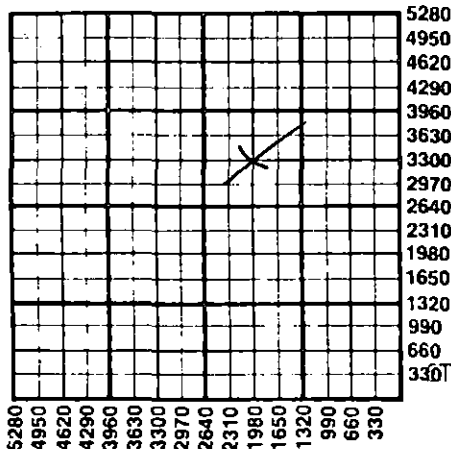

1. Notify District office before setting surface casing.
 2. Set surface casing by circulating cement to the top.
 3. File completion forms ACO-1 with K.C.C. within 90 days of well completion, following instructions on ACO-1, side 1, and including copies of wireline logs.
 4. Notify District office 48 hours prior to old well workover or re-entry.
 5. Prior to plugging, prepare a plugging plan, then obtain agreement from the appropriate district office for an approved plugging plan.
 6. Submit plugging report (CP-4) to K.C.C. after plugging is completed.
 7. Obtain an approved injection docket number before disposing of salt water.
 8. Notify K.C.C. within 10 days when injection commences or terminates.
9. If an alternate 2 completion, cement in the production pipe from below any usable water to surface within 120 days of spud date.

RECEIVED
 STATE CORPORATION COMMISSION

OCT 24 1984
 10-24-84
 CONSERVATION DIVISION

State Corporation Commission of Kansas
 Conservation Division
 200 Colorado Derby Building
 Wichita, Kansas 67202
 (316) 263-3238