

CARD MUST BE TYPED

State of Kansas
NOTICE OF INTENTION TO DRILL
(see rules on reverse side)

CARD MUST BE SIGNED

Starting Date: 11-7-84
month day year

API Number 15- 009-23,759 0000

OPERATOR: License # 5770
Name Reif Oil Operations Inc.
Address Box 298
City/State/Zip Hoisington, Kansas 67544
Contact Person Don Reif
Phone 316-653-7745

SE SE NW Sec 8 Twp 16 S, Rge 12
(location) East West

2970 Ft North from Southeast Corner of Section
2970 Ft West from Southeast Corner of Section
(Note: Locate well on Section Plat on reverse side)

CONTRACTOR: License # 5671
Name Revlin Drlg., Inc.
City/State Russell, Kansas 67665

Nearest lease or unit boundary line 330 feet.
County Barton

Lease Name Emma Staudinger Well# 1

Domestic well within 330 feet: yes no

Municipal well within one mile: yes no

Well Drilled For: Well Class: Type Equipment:
 Oil Swd Infield Mud Rotary
 Gas Inj Pool Ext. Air Rotary
 OWWO Expl Wildcat Cable

Depth to Bottom of fresh water 100 250 mhc
Lowest usable water formation Dakota

Depth to Bottom of usable water 400 feet

Surface pipe by Alternate: 1 2

Surface pipe to be set 800 feet

Conductor pipe if any required feet

Ground surface elevation feet MSL

This Authorization Expires 4-18-85

Approved By 10-18-84 R

If OWWO: old well info as follows:

Operator
Well Name
Comp Date Old Total Depth
Projected Total Depth feet
Projected Formation at TD 3400
Expected Producing Formations

I certify that we will comply with K.S.A. 55-101, et seq., plus eventually plugging hole to K.C.C. specifications.

Date 10-17-84 Signature of Operator or Agent Paula J. Gibson Title Agent

mhc/KDHE 10/18/84

Must be filed with the K.C.C. five (5) days prior to commencing well
 This card void if drilling not started within six (6) months of date received by K.C.C.

RECEIVED
 STATE CORPORATION COMMISSION


OCT 18 1984

CONSERVATION DIVISION
 Wichita, Kansas

10-18-84

Important procedures to follow:

**A Regular Section of Land
 1 Mile = 5,280 Ft.**

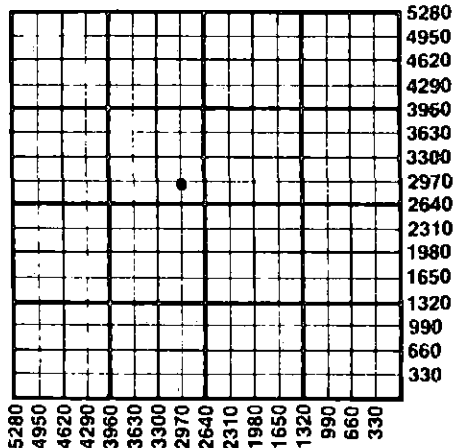

1. Notify District office before setting surface casing.
2. Set surface casing by circulating cement to the top.
3. File completion forms ACO-1 with K.C.C. within 90 days of well completion, following instructions on ACO-1, side 1, and including copies of wireline logs.
4. Notify District office 48 hours prior to old well workover or re-entry.
5. Prior to plugging, prepare a plugging plan, then obtain agreement from the appropriate district office for an approved plugging plan.
6. Submit plugging report (CP-4) to K.C.C. after plugging is completed.
7. Obtain an approved injection docket number before disposing of salt water.
8. Notify K.C.C. within 10 days when injection commences or terminates.
9. If an alternate 2 completion, cement in the production pipe from below any usable water to surface within 120 days of spud date.

State Corporation Commission of Kansas
 Conservation Division
 200 Colorado Derby Building
 Wichita, Kansas 67202
 (316) 263-3238