


WELL PLUGGING RECORD

OR 15-009-06773-0000
FORMATION PLUGGING RECORD Strike out upper line when reporting plugging of formations.

Give All Information Completely
Make Required Affidavit
Mail or Deliver Report to:
Conservation Division
State Corporation Commission
800 Bittling Building
Wichita, Kansas

NORTH

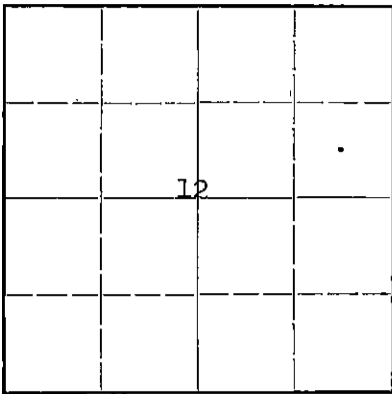

Locate well correctly on above Section Plat

Barton County. Sec. 12 Twp. 16S Rge. 16W
Location as "NE $\frac{1}{4}$ NW $\frac{1}{4}$ SW $\frac{1}{4}$ " or footage from lines SE NE NW
Lease Owner Bridgeport Oil Company, Inc.
Lease Name Thill "B" Well No. I
Office Address 918 Central Building - Wichita 2, Kansas.
Character of Well (completed as Oil, Gas or Dry Hole) Dry hole
Date well completed 12 - 27 1944
Application for plugging filed 12 - 27 1944
Application for plugging approved 12 - 27 1944
Plugging commenced 12 - 27 1944
Plugging completed 12 - 27 1944
Reason for abandonment of well or producing formation Dry hole

If a producing well is abandoned, date of last production 19
Was permission obtained from the Conservation Division or its agents before plugging was commenced? Yes

Name of Conservation Agent who supervised plugging of this well Mr. Ruel Durkee
Producing formation Depth to top Bottom Total Depth of Well 3405 Feet
Show depth and thickness of all water, oil and gas formations.


OIL, GAS OR WATER RECORDS

CASING RECORD

Formation	Content	From	To	Size	Put In	Pulled Out
				8 5/8"	287'	None

Describe in detail the manner in which the well was plugged, indicating where the mud fluid was placed and the method or methods used in introducing it into the hold. If cement or other plugs were used, state the character of same and depth placed, from feet to feet for each plug set.

Filled hole with mud 3405' to 280'
Set plug at 280' with 20 sacks cement
Filled hole with mud to 35'
Set plug at 35' and cemented on top of plug with 5 sacks to within 6' of top

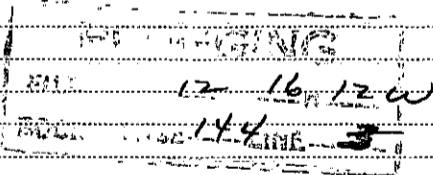

(If additional description is necessary, use BACK of this sheet)

Correspondence regarding this well should be addressed to Bridgeport Oil Company, Inc.,
Address 918 Central Building - Wichita 2, Kansas.

STATE OF Kansas, COUNTY OF Sedgwick, ss.
Frank Leach (employee of owner) or (owner or operator) of the above-described well,

being first duly sworn on oath, says: That I have knowledge of the facts, statements, and matters herein contained and the log of the above-described well as filed and that the same are true and correct. So help me God.

(Signature) *Frank Leach*

Wichita, Kansas. 4-13-45
(Address) CONSERVATION DIVISION 1945

SUBSCRIBED AND SWORN to before me this 3rd day of January, 1945

My commission expires Oct. 29, 1947

Virginia Boyer Notary Public.

01-04-45

BRIDGEPORT OIL COMPANY, INC.,
 918 CENTRAL BUILDING,
 WICHITA 2, KANSAS.

Well Log-----Thill "B" #1
 SE NE NW 12-16S-12W
 Barton County, Kansas

Elevation-----1892 I&S
 Date Started----11-29-44
 Date Completed--12-27-44

Casing Record:
 8 5/8" casing cemented @ 287'
 with 150 sacks bulk cement.

Rotary Tools---- 0 to 3405'

LOG	
0	40 Surface, Clay & Shells
40	75 Shale & Shells
75	184 Shale & Lime Shells
184	287 Shale, Lime & Sand Stones
287	485 Shale & Shells
485	650 Shale & Red Rock
650	740 Sand
740	1045 Lime & Shale
1045	1214 Shale
1214	1350 Shale & Shells
1350	1365 Salt & Shells
1365	1465 Shale & Shells
1465	1510 Shale
1510	1560 Anhydrite
1560	1825 Lime & Shale
1825	1895 Shale
1895	1924 Sandy Lime
1924	1992 Lime & Shale
1992	2018 Shale & Shells
2018	2160 Lime & Shale
2160	2240 Shale & Lime
2240	2435 Lime & Shale
2435	2490 Shale & Shells
2490	2580 Lime & Shale
2580	2630 Broken Lime
2630	2650 Lime & Shale
2650	2753 Lime
2753	2775 Lime & Shale
2775	2970 Lime
2970	3030 Lime & Shale
3030	3045 Shale
3045	3330 Lime
3330	3337 Lime & Shale
3337	3371 Conglomerate
3371	3405 Arbuckle
3405	T.D.

Plugged & Abandoned 12-27-44

FORMATION TOPS - DF	
Top Topeka	2665'
Top Lansing	3058'
Top Conglomerate	3337'
Top Arbuckle	3369'

I, Frank Leach, do hereby certify that the above log is correct to the best of my knowledge and belief.

BRIDGEPORT OIL COMPANY, INC.

By: Frank Leach

12 16 12W
 144 3

Bridgeport Oil Company, Inc.

Production of Crude Oil



GENERAL OFFICES — WICHITA 1, KANSAS

January 3, 1945

Re: Thill "B" #1
SE NE NW 12-16S-12W
Barton County, Kansas

Conservation Division,
State Corporation Commission,
800 Bitting Building,
Wichita 2, Kansas.

Gentlemen:

Attached is copy of Well Plugging Application Form, one executed copy of the Log, and one certified copy of the Well Plugging Record form covering the captioned well.

Very truly yours,

BRIDGEPORT OIL COMPANY, INC.

Frank Leach
Production Manager

FL:bls
att. (3)

