

15-009-06006-0000

WELL PLUGGING RECORD

Give All Information Completely
The Required Affidavit
Will or Deliver Report to:
Conservation Division
State Corporation Commission
211 No. Broadway
Wichita, Kansas

Barton County, Sec. 12 Twp. 16S Rge. 12W (E) (W)

Location as "NE/CNW/SW" or footage from lines N/2 S/2 NW

Lease Owner Howard Alexander

Lease Name Weber #11 Well No. #11

Office Address P. O. Box 1043, Tulsa, Oklahoma

Character of Well (completed as Oil, Gas or Dry Hole) Dry Hole

Date well completed 5-16-63 19

Application for plugging filed 5-16-63 19

Application for plugging approved 5-16-63 19


Plugging commenced 5-16-63 19

Plugging completed 5-16-63 19

Reason for abandonment of well or producing formation Dry Hole

If a producing well is abandoned, date of last production _____ 19

Was permission obtained from the Conservation Division or its agents before plugging was commenced? yes

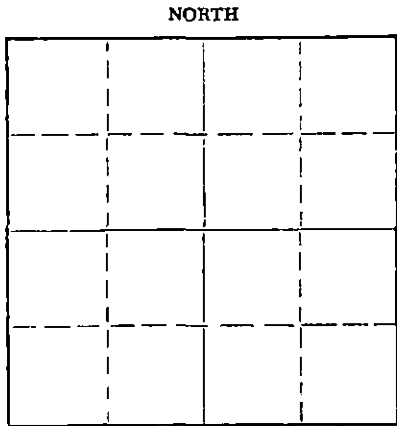

Locate well correctly on above Section Plat

Name of Conservation Agent who supervised plugging of this well Eldon Petty, Hays, Kansas for Donald Truan

Producing formation _____ Depth to top _____ Bottom _____ Total Depth of Well 3380 Feet

Show depth and thickness of all water, oil and gas formations.

OIL, GAS OR WATER RECORDS

CASING RECORD

FORMATION	CONTENT	FROM	TO	SIZE	PUT IN	PULLED OUT
				8 5/8"	307'	none

Describe in detail the manner in which the well was plugged, indicating where the mud fluid was placed and the method or methods used in introducing it into the hole. If cement or other plugs were used, state the character of same and depth placed, from _____ feet to _____ feet for each plug set.

Mud to 300', Plug, 1/4 sack hulls, 30 sacks cement

Mud to 40', Plug, 1/4 sack hulls, 10 sacks cement

RECEIVED
STATE CORPORATION COMMISSION

MAY 22 1963

CONSERVATION DIV. #
Wichita, Kansas

(If additional description is necessary, use BACK of this sheet)

Name of Plugging Contractor Leben Drilling, Inc.

Address P. O. Box 486, Great Bend, Kansas

STATE OF KANSAS, COUNTY OF BARTON, ss.

Leslie Kite (employee of owner) or (owner or operator) of the above-described well, being first duly sworn on oath, says: That I have knowledge of the facts, statements, and matters herein contained and the log of the above-described well as filed and that the same are true and correct. So help me God.

(Signature) Leslie Kite

P. O. Box 486, Great Bend, Kansas
(Address)

SUBSCRIBED AND SWORN TO before me this 20th day of May, 1963

My commission expires April 1, 1967

Ulanda Nichols
Ulanda Nichols, Notary Public Notary Public.

DRILLER'S LOG

COMPANY: Howard Alexander
 CONTRACTOR: LEBEN DRILLING, INC.
 FARM: WEBER #11
 LOCATION: N/2 S/2 NW Sec. 12-16S-12W
 BARTON COUNTY, KANSAS
 COMMENCED: 5-9-63
 COMPLETED: 5-16-63

0	35	Surface Soil and Lime Stone
35	60	Clay
60	260	Shale
260	308	Redbed & Clay
308	630	Shale & Redbed
630	735	Redbed & Shale
735	770	Anhydrite
770	1200	Shale
1200	1610	Shale & Lime
1610	1815	Shale & Shells
1815	2200	Lime
2200	2645	Shale & Lime
2645	3000	Lime
3000	3060	Lime & Shale
3060	3380	Lime
	<u>3380</u>	<u>Rotary Total Depth - D. & A.</u>

RECEIVED
 STATE CORPORATION COMMISSION

MAY 22 1963

CONSERVATION DIVISION
 Wichita, Kansas

Set 8 5/8" used surface casing @ 307' Cemented with 175 sacks Posmix with HA5

I, Leslie Kite, do hereby certify that the above and foregoing is a true and correct copy of the log of the Weber #11, located North half of South half of NW, Section 12, Township 16 South, Range 12 West, Barton County, Kansas, as reflected by the files of Leben Drilling, Inc.

Leslie Kite

Leslie Kite

STATE OF KANSAS)
) SS
 COUNTY OF BARTON)

Subscribed and sworn to before me, a Notary Public, in and for Barton County, Kansas, this 20th day of May, 1963.

Ulanda Nichols

Ulanda Nichols, Notary Public

My Commission Expires:
 April 1, 1967