


STATE OF KANSAS
STATE CORPORATION COMMISSION

WELL PLUGGING RECORD

Give All Information Completely
Make Required Affidavit
Mail or Deliver Report to
Conservation Division
State Corporation Comm.
245 North Water
Wichita, KS 67202

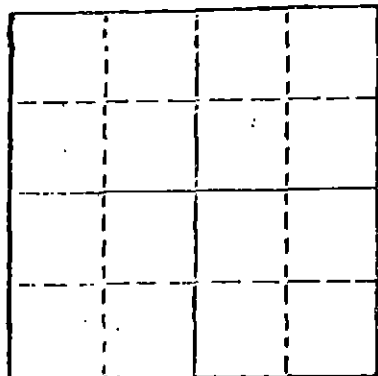

Locate well correctly on above
Section Plat

McPherson County, Sec. 5 Twp. 21 Rge. 1 E/W
Location as "NE/CNW $\frac{1}{2}$ SW $\frac{1}{2}$ " or footage from lines
330' S 450' W NE/4
Lease Owner National Development Co.
Lease Name Theis #1 Well No.
Office Address Wichita, Kansas 67202
Character of Well (Completed as Oil, Gas or Dry Hole)

Date Well completed 19
Application for plugging filed 19
Application for plugging approved 19
Plugging commenced 6/10/80 19
Plugging completed 6/16/80 19
Reason for abandonment of well or producing formation
depleted.
If a producing well is abandoned, date of last production 19

Was permission obtained from the Conservation Division or
its agents before plugging was commenced? yes

Name of Conservation Agent who supervised plugging of this well Toman
Producing formation Depth to top Bottom Total Depth of Well 3030
Show depth and thickness of all water, oil and gas formations.

OIL, GAS OR WATER RECORDS

CASING RECORD

FORMATION	CONTENT	FROM	TO	SIZE	PUT IN	PULLED OUT
				8-5/8	202ft.	none
				4 1/2"	3030	2188

Describe in detail the manner in which the well was plugged, indicating where the mud fluid
was placed and the method or methods used in introducing it into the hold. If cement or other
plugs were used, state the character of same and depth placed, from feet to
feet for each plug set.

Sanded to 2950' and set 3 sacks cement. Loaded hole, shot pipe at 2713', 2609', 2511',
2406', 2303', 2202', worked pipe loose and pulled 65 joints. Bailed hole to 250' and set
rock bridge from 250 to 230', ran 4 yards ready mix.

PLUGGING COMPLETE.

6-23-80

(If additional description is necessary, use BACK of this sheet)

Name of Plugging Contractor KELSO CASING PULLING CO
CHASE, KANSAS

STATE OF KANSAS COUNTY OF RICE, ss.
R. DARRELL KELSO (employee of owner) or (owner or operator)
of the above-described well, being first duly sworn on oath, says: That I have knowledge of
the facts, statements, and matters herein contained and the log of the above-described well
as filed and that the same are true and correct. So help me God.

(Signature) R. Darrell Kelso
CHASE, KANSAS

SUBSCRIBED AND SWORN TO before me this 20th day of June, 19 80

Margaret Melcher
Notary Public.

My commission expires



15.113.20547-0000

Electra Inc.

SEC. 5 TWP. 21S RGE. 1W

RADIATION ACCURLOG

RECEIVED
MAY 1980
RADIATION DIVISION
Topeka, Kansas
COMMISSION

3030' D 4 1/2"
60 Sack of Cement
Reported 2980-2984
3002-3006
3017-3006

COMPANY NATIONAL DEVELOPMENT CO.

WELL THEIS # 1

FIELD

COUNTY McPHERSON

STATE KANSAS

Location 330'S 450'W NE 1/4

Other Services:

Sec. 5 Twp. 21S Rge. 1W

Permanent Datum: Ground Level, Elev. 1516'

Elev.: K.B. 1524'

Log Measured From K. B., Eight Ft. Above Perm. Datum

D.F.

Drilling Measured From Kelly Bushing

G.L. 1516'

Date	5-23-78						
Run No.	One						
Depth—Driller	3030						
Depth—Logger	3031						
Btm. Log Inter.	3031						
Top Log Inter.	2600						
Casing—Driller	8 5/8 @ 202'			⊙	⊙	⊙	⊙
Casing—Logger							
Bit Size	7 7/8						
Type Fluid in Hole	Starch Mud						
Dens.	Visc.	9.8 44					
pH	Fluid Loss	NA	NA ml	ml	ml	ml	ml
Source of Sample	Flow Line						
R _{ms} @ Meas. Temp.	.8	@ 75 °F	⊙	⊙	⊙	⊙	⊙
R _{ms} @ Meas. Temp.	.65	@ 75 °F	⊙	⊙	⊙	⊙	⊙
R _{ms} @ Meas. Temp.		@ °F	⊙	⊙	⊙	⊙	⊙
Source: R _{ms}	R _{ms}	Charts					
R _{ms} @ BHT	.45	@ 100 °F	⊙	⊙	⊙	⊙	⊙
Time Since Circ.	3 Hours						
Max. Rec. Temp.	100	°F	°F	°F	°F	°F	°F
Location	136 1GT. BD.						
	J. McKim						
	Mr. Hamilton & Mr. Merchant						