


STATE OF KANSAS  
STATE CORPORATION COMMISSION

WELL PLUGGING RECORD

Give All Information Completely  
Make Required Affidavit  
Mail or Deliver Report to  
Conservation Division  
State Corporation Comm.  
245 North Water  
Wichita, KS 67202

McPherson County, Sec. 5 Twp. 21 Rge. 1 E/W  
Location as "NE/CNW $\frac{1}{4}$ /SW $\frac{1}{4}$ " or footage from lines \_\_\_\_\_  
70' South of center E/2-E/2-NE  
Lease Owner National Development Company  
Lease Name Johnson Well No. 1  
Office Address Suite 636 300 West Douglas Wichita Ks.  
Character of Well (Completed as Oil, Gas or Dry Hole) \_\_\_\_\_  
Dry hole  
Date Well completed 7-29-77 19  
Application for plugging filed 7-29-77 19  
Application for plugging approved 7-29-77 19  
Plugging commenced 8:45 A. M. 7-29-77 19  
Plugging completed 9:00 A. M. 7-29-77 19  
Reason for abandonment of well or producing formation \_\_\_\_\_

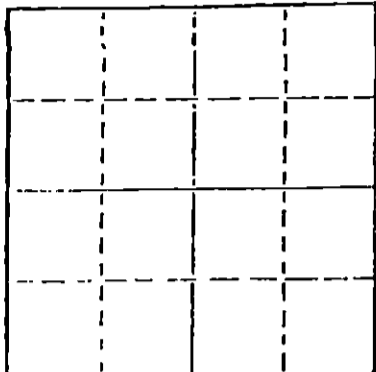

Locate well correctly on above  
Section Plat

If a producing well is abandoned, date of last production \_\_\_\_\_ 19

Was permission obtained from the Conservation Division or  
its agents before plugging was commenced? yes

Name of Conservation Agent who supervised plugging of this well Hugh Scott  
Producing formation \_\_\_\_\_ Depth to top \_\_\_\_\_ Bottom \_\_\_\_\_ Total Depth of Well 3015'  
Show depth and thickness of all water, oil and gas formations.

OIL, GAS OR WATER RECORDS

CASING RECORD

FORMATION	CONTENT	FROM	TO	SIZE	PUT IN	PULLED OUT

Describe in detail the manner in which the well was plugged, indicating where the mud fluid was placed and the method or methods used in introducing it into the hold. If cement or other plugs were used, state the character of same and depth placed, from \_\_\_\_\_ feet to \_\_\_\_\_ feet for each plug set.

Bottom Plug at 225' W/25 sacks cement  
Top plug at 40' W/10 sacks cement  
2 sacks in rat hole

RECEIVED  
AUG 04 1977  
8-1-77  
CONSERVATION DIVISION  
STATE OF KANSAS

(If additional description is necessary, use BACK of this sheet)

Name of Plugging Contractor L. D. Drilling Company

STATE OF Kansas COUNTY OF Barton, ss.  
Wayne Dobbs (employee of owner) or (owner or operator)  
of the above-described well, being first duly sworn on oath, says: That I have knowledge of the facts, statements, and matters herein contained and the log of the above-described well as filed and that the same are true and correct. So help me God.

(Signature) Wayne Dobbs  
Wayne Dobbs Great Bend, Kansas 67530  
(Address)

SUBSCRIBED AND SWORN TO before me this 29th day of July, 19 77

Bessie M. DeWerff  
Bessie M. DeWerff Notary Public.

My commission expires 5-20-81

BESSIE M. DEWERFF  
STATE NOTARY PUBLIC  
BARTON COUNTY, KANSAS  
MY APPT. EXP. \_\_\_\_\_

DRILLERS WELL LOG

L. D. DRILLING COMPANY - CONTRACTOR NATIONAL DEVELOPMENT - OPERATOR

JOHNSON # 1  
70' S/of center E/2-E/2-NE 5-21-1  
MCPHERSON COUNTY, KANSAS

T. D. 3015'  
ELEV. 1513 KB

COMMENCED: 7-22-77  
COMPLETED: 7-29-77

Casing:  
8 5/8" set at 219'

Cement:  
130 Sx. 60/40 Pozmix, 2% Gel, 3% CC

FORMATION

DEPTH

Shale with sand streaks  
Lime & Shale  
Miss. chat

0 - 500  
500 - 2998  
2998 - 3015

TOPS

Miss Chat  
T.D.

2998  
3015

2998  
1513  
1485

AFFIDAVIT

State of Kansas. County of Barton

I, Wayne Dobbs of the L. D. DRILLING COMPANY

being first duly sworn on oath, State: That I have knowledge of the facts statements and matters herein contained and that the same are true and correct.

Wayne Dobbs  
Wayne Dobbs

Subscribed and sworn to before me on this 29th day of July 1977

My commission expires: 5-20-81

Bessie M. DeWerff  
Notary Public: Bessie M. DeWerff

BESSIE M. DEWERFF  
STATE NOTARY PUBLIC  
BARTON COUNTY, KANSAS  
MY APPT. EXP. \_\_\_\_\_

15 JUL 1977