


STATE OF KANSAS
STATE CORPORATION COMMISSION

Form CP-4

Give All Information Completely
Make Required Affidavit
Mail or Deliver Report to:
Conservation Division
State Corporation Commission
212 No. Market
Wichita, Kansas

WELL PLUGGING RECORD

NORTH

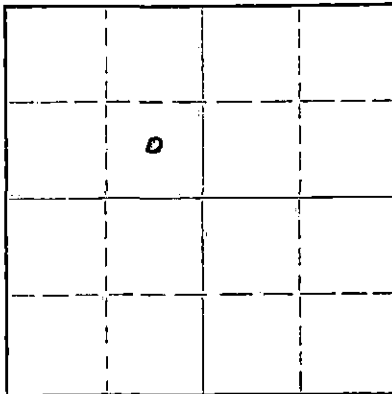

Locate well correctly on above
Section Plat

McPherson County, Sec. 27 Twp. 21 Rge. 1 (E) 1 (W)
Location as "NE/CNW/SW" or footage from lines 70'N 50'E CSE NW
Lease Owner Pyramid Corp. Inc.
Lease Name Goering Well No. 1
Office Address 3000 West Kellogg
Character of Well (completed as Oil, Gas or Dry Hole) dry hole
Date well completed 6/27/67 1967
Application for plugging filed 6/27 1967
Application for plugging approved " 1967
Plugging commenced " 1967
Plugging completed " 1967
Reason for abandonment of well or producing formation dry hole

If a producing well is abandoned, date of last production 19
Was permission obtained from the Conservation Division or its agents before plugging was commenced? yes

Name of Conservation Agent who supervised plugging of this well Hugh Scott
Producing formation _____ Depth to top _____ Bottom _____ Total Depth of Well 3500 Feet
Show depth and thickness of all water, oil and gas formations.

OIL, GAS OR WATER RECORDS

CASING RECORD

| FORMATION | CONTENT | FROM | TO | SIZE | PUT IN | PULLED OUT |
|-----------|---------|------|----|-------|--------|------------|
| | | | | 8 5/8 | 232 | none |
| | | | | | | |
| | | | | | | |
| | | | | | | |
| | | | | | | |
| | | | | | | |
| | | | | | | |

Describe in detail the manner in which the well was plugged, indicating where the mud fluid was placed and the method or methods used in introducing it into the hole. If cement or other plugs were used, state the character of same and depth placed, from _____ feet to _____ feet for each plug set.

with drilling mud

Filled hole to 230', set plug at 230', put 25sx cement on plug, filled hole to 30' with drilling mud, set plug at 30', put 10sx cement on plug

RECEIVED
STATE CORPORATION COMMISSION

JUL 11 1967

CONSERVATION DIVISION
Wichita, Kansas

(If additional description is necessary, use BACK of this sheet)

Name of Plugging Contractor Melland Drilling co., Inc.
Address Box 783, McPherson, Kansas

STATE OF Kansas, COUNTY OF McPherson, ss.
Donald J. Melland (employee of owner) or (owner or operator) of the above-described well, being first duly sworn on oath, says: That I have knowledge of the facts, statements, and matters herein contained and the log of the above-described well as filed and that the same are true and correct. So help me God.

(Signature)

Box 783, McPherson, Kansas
(Address)

SUBSCRIBED AND SWORN TO before me this 5th day of July, 19 67

My commission expires December 23, 1967

Notary Public.

WELL RECORD

LEASE: Goering

WELL NO. 1

ELEVATION:

LOCATION: 70°N 50°E CSE NW
Sec. 27-21-1W

COMMENCED: 6/15/67

COMPLETED: 6/27/67

OPERATOR: Pyramid Corp, Inc.

CONTRACTOR: Melland Drilling Company, Inc.
Post Office Box 783
McPherson, Kansas

CASING RECORD: 8 5/8" @ 232'/150sx

| FORMATION | LOG | FORMATION | LOG |
|----------------|------|-----------|-----|
| surface clay | 40 | | |
| sand | 64 | | |
| shale | 104 | | |
| shale & shells | 232 | | |
| shale & shells | 441 | | |
| lime & shale | 865 | | |
| shale & lime | 2015 | | |
| lime & shale | 2338 | | |
| shale & lime | 2441 | | |
| lime & shale | 2615 | | |
| shale & lime | 2780 | | |
| lime & shale | 3030 | | |
| Mississippi | 3350 | | |
| shale | 3485 | | |
| lime & shale | 3500 | | |
| RTD | 3500 | | |

RECEIVED
JUL 11 1967
McPherson, Kansas

CERTIFICATE

State of Kansas, County of McPherson, ss.

I, Donald J. Melland, do hereby certify that the above is a true and correct copy of the log of the above named and described well, as reflected by the records of the Melland Drilling Company, Inc.

Donald J. Melland

Subscribed and sworn to before me, a Notary Public, in and for the County of McPherson, State of Kansas,
this 5th day of July, 1967.

My Commission expires: December 23, 1967

[Signature]
Notary Public