


Give All Information Completely
Make Required Affidavit
Mail or Deliver Report to:
Conservation Division
State Corporation Commission
212 North Market, Insurance Bldg.
Wichita, Kansas

WELL PLUGGING RECORD

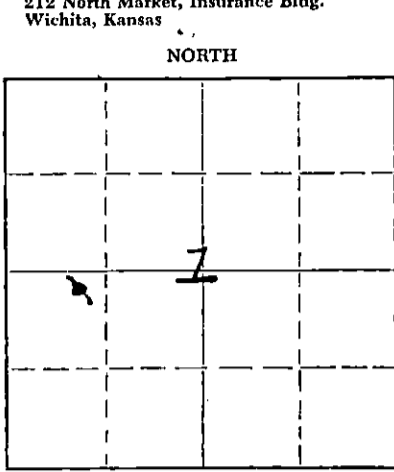

Locate well correctly on above Section Plat

Rice County, Sec. 1 Twp. 21 Rge. 6 (E) W (W)
Location as "NE/CNW/SW" or footage from lines NE NW SW
Lease Owner Oil Property Management, Inc.
Lease Name Lackey "A" #2 Well No. _____
Office Address Wichita, Kansas
Character of Well (completed as Oil, Gas or Dry Hole) _____
Date well completed _____ 19____
Application for plugging filed _____ 19____
Application for plugging approved _____ 19____
Plugging commenced 5-22-59 19____
Plugging completed 5-26-59 19____
Reason for abandonment of well or producing formation _____

If a producing well is abandoned, date of last production _____ 19____
Was permission obtained from the Conservation Division or its agents before plugging was commenced? yes

Name of Conservation Agent who supervised plugging of this well Gilbert Toman
Producing formation _____ Depth to top _____ Bottom _____ Total Depth of Well 3397' Feet
Show depth and thickness of all water, oil and gas formations.

OIL, GAS OR WATER RECORDS

CASING RECORD

FORMATION	CONTENT	FROM	TO	SIZE	PUT IN	PULLED OUT
				8-5/8"	140'	none
				5-1/2"	3375'	2597'

Describe in detail the manner in which the well was plugged, indicating where the mud fluid was placed and the method or methods used in introducing it into the hole. If cement or other plugs were used, state the character of same and depth placed, from _____ feet to _____ feet for each plug set.

Checked the hole to 3397' and found it open. Filled w/sand to 3365' and dumped 5 sacks of cement with bailer. Pulled 5 1/2" casing, cleaned hole and mudded the hole to 220', set rock bridge to 210' and dumped 25 sacks of cement. Mudded the hole to 40' set rock bridge to 30' and ran 10 sacks of cement to base of cellar.

PLUGGING COMPLETED

RECEIVED
STATE CORPORATION COMMISSION

JUN 2 1959

CONSERVATION DIVISION
Wichita, Kansas

(If additional description is necessary, use BACK of this sheet)
Name of Plugging Contractor West Supply Co., Inc. 6-2-59
Address Chase, Kansas

STATE OF KANSAS, COUNTY OF RICE, ss.
I, Noel J. Knight (employee of owner) or (owner or operator) of the above-described well, being first duly sworn on oath, says: That I have knowledge of the facts, statements, and matters herein contained and the log of the above-described well as filed and that the same are true and correct. So help me God.

(Signature) Noel J. Knight
Chase, Kansas (Address)

SUBSCRIBED AND SWORN TO before me this 28th day of May, 19 59

Thomas V. Dwyer
Notary Public.

My commission expires 9-27-62

PLUGGING
FILE SEC 1.121 R 64
BOOK PAGE 36 U-E 12

REC'D MAY 29 1959

CONTRACTORS WELL LOG

OPERATOR Star Drilling Inc., et al FARM NAME Lackey WELL NO. 2
 LOCATION NE NW SW Sect 26 1-21-6 COUNTY Rice STATE Kansas
 COMMENCEMENT DATE 3/14/54 COMPLETION DATE 3/24/54

LOG OF WELL

FROM	TO	FORMATION	DEVIATION FROM VERTICAL	REMARKS
0	140	Surface soil		
140	330	Red bed		
330	550	shale shells		
550	840	salt		
840	1120	lime shale		
1120	1200	Shale shells		
1200	1540	lime shale		
1540	2255	shale shells		
2255	2390	lime shale		
2390	2567	lime		
2567	2572	shale		
2572	2764	lime shale		
2764	3066	lime		
3066	3080	lime shale		
3080	3260	lime		
3260	3320	lime shale		
3320	3345	congl. shale cherty		
3345	3370	congl.		
3370	3375	Miss Total Depth		

RECEIVED
 STATE OF KANSAS COMMISSION
 MAY 7 1959
 CONSERVATION DIVISION
 Wichita, Kansas

Set 140' (6 jts) 8 5/8" casing
 Set 3375' (113 jts) 5 1/2" casing

STATE OF KANSAS)
) SS
 COUNTY OF RICE)

The undersigned certifies that to the best of his knowledge and belief the above facts are true and correct.

STAG DRILLING, INC.,
 BY: C. L. Russell
 President

Subscribed and sworn to before me this 23rd 5th day of April, 1954

My Commission Expires 3/1/55

Orlando Miller
 Notary Public

PLUGGING
 FILE SEC. 1 T 21 R 6W
 BOOK PAGE 36 LINE 12