

WELL PLUGGING RECORD

STATE OF KANSAS
STATE CORPORATION COMMISSION


Give All Information Completely
Make Required Affidavit
Mail or Deliver Report to:
Conservation Division
State Corporation Commission
800 Bitting Building
Wichita, Kansas

FORMATION PLUGGING RECORD

Strike out upper line
when reporting plugging
of formations.

Rice County. Sec. 1 Twp. 21 Rge. 6 (E) (W)
 Location as "NE $\frac{1}{4}$ NW $\frac{1}{4}$ SW $\frac{1}{4}$ " or footage from lines SE $\frac{1}{4}$ NE $\frac{1}{4}$ NW $\frac{1}{4}$
 Lease Owner Nelson Drilling Company
 Lease Name Lackey Well No. 1
 Office Address 508 Wolcott Bldg. Hutchinson, Kansas
 Character of Well (completed as Oil, Gas or Dry Hole) Dry hole
 Date well completed September 11, 1943 19
 Application for plugging filed November 3 19 43
 Application for plugging approved November 5 19 43
 Plugging commenced October 30 19 43
 Plugging completed November 6 19 43
 Reason for abandonment of well or producing formation Dry hole

NORTH

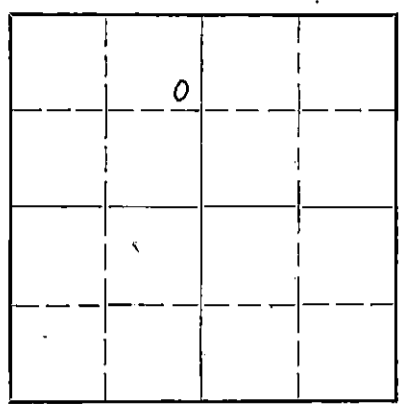

Locate well correctly on above
Section Plat

If a producing well is abandoned, date of last production 19
 Was permission obtained from the Conservation Division or its agents before plugging was commenced? yes

Name of Conservation Agent who supervised plugging of this well Ruel Durkee
 Producing formation Depth to top Bottom Total Depth of Well 3382 Feet
 Show depth and thickness of all water, oil and gas formations.

OIL, GAS OR WATER RECORDS

CASING RECORD

Formation	Content	From	To	Size	Put In	Pulled Out
				8 5/8 "	152	None
				5 1/2 "	3342 ft.	3025 ft.

Describe in detail the manner in which the well was plugged, indicating where the mud fluid was placed and the method or methods used in introducing it into the hold. If cement or other plugs were used, state the character of same and depth placed, from feet to feet for each plug set.

Filled hole full cement from 3382 ft. to 3330 ft. Ripped pipe off at 3025 ft. Filled hole full heavy mud through 5 inch casing, then pulled out 3025 ft. casing. Finished filling hole full heavy mud within 12 ft. of top and put in 6 sacks cement in cellar.

PLUGGING
 FILED NOV 12 1943
 97-NE-23

STATE CORPORATION COMMISSION
 NOV 12 1943
 11-12-43

(If additional description is necessary, use BACK of this sheet)

Correspondence regarding this well should be addressed to C. C. Nelson Drilling Company
 Address 508 Wolcott Bldg. Hutchinson, Kansas

STATE OF Kansas, COUNTY OF Reno, ss.
 C. C. Nelson (employee of owner) or (owner or operator) of the above-described well,

being first duly sworn on oath, says: That I have knowledge of the facts, statements, and matters herein contained and the log of the above-described well as filed and that the same are true and correct. So help me God.

(Signature) C. C. Nelson

Hutchinson, Kansas (Address)

SUBSCRIBED AND SWORN to before me this 11 day of November, 19 43

My Co. Eva B. Sage

Notary Public.

My commission expires.

COMPANY: O. G. Nelson Drilling Company
 CONTRACTOR: O. G. Nelson Drilling Company
 WELP: Lackey #1
 LOCATION: Section 1-21-6 Rice County, Kansas
 CORNER: SW/4 NW/4 NW/4
 COMMENCED: August 25, 1943
 COMPLETED: September 11, 1943

0	to	152	Surface
152	to	850	Shale
850	to	950	Lime
950	to	1125	Shale
1125	to	1360	Lime
1360	to	1550	Shale
1550	to	1575	Lime
1575	to	2260	Shale
2260	to	2580	Lime
2580	to	2695	Shale
2695	to	2855	Lime
2855	to	2880	Soft lime
2880	to	3260	Lime
3260	to	3342	Shale
3342	to	3350	Chert
3350	to	3371	Chert & lime
3371	to	3382	Chert
		3382	N. D.

Set 152 feet of 8 5/8 inch surface pipe. Cemented with 80 sacks cement.

700 ft. fluid in hole in 8 hours. 200 ft oil, balance water.

Set 3342 feet of 5 1/2" casing. Cemented with 50 sacks cement.

CERTIFICATION

I, O. G. Nelson, do hereby certify that the above and foregoing is a true and correct copy of log of the Lackey #1, Section 1-21-6, Rice County, Kansas, as reflected by files of the O. G. Nelson Drilling Company.

Subscribed and sworn to before me, a Notary Public, within and for Reno, County, Kansas, _____ this day of September 1943.

