

15-145-61286-6000

STATE OF KANSAS  
STATE CORPORATION COMMISSION

WELL PLUGGING RECORD

OR

FORMATION PLUGGING RECORD

Strike out upper line  
when reporting plug-  
ging of formations.

Give All Information Completely  
Make Required Affidavit  
Mail or Deliver Report to:  
Conservation Division  
State Corporation Commission  
800 Bittling Building  
Wichita, Kansas

*Pawnee* County, Sec. *1* Twp. *27* Rge. *5* (E) *5* (W)

Location as "NE 1/4 NW 1/4 SW 1/4" or footage from lines *330 N 330 E*

Lease Owner *Herndon Sulg Co*

Lease Name *Julia, Oklahoma* Well No. *1*

Office Address *Julia, Oklahoma*

Character of Well (completed as Oil, Gas or Dry Hole) *Dry hole*

Date well completed *7-31* 19 *42*

Application for plugging filed *8-8* 19 *42*

Application for plugging approved *8-6* 19 *42*


Plugging commenced *8-7* 19 *42*

Plugging completed *8-7* 19 *42*

Reason for abandonment of well or producing formation *Dry hole*

If a producing well is abandoned, date of last production 19

Was permission obtained from the Conservation Division or its agents before plugging was commenced? *Yes*

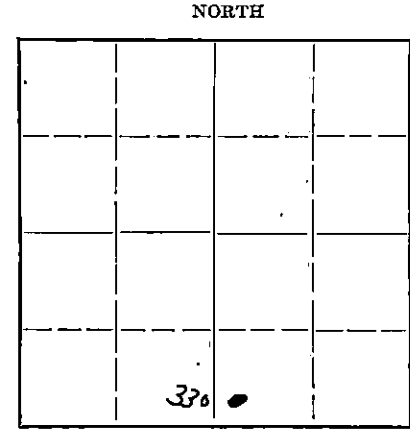

Locate well correctly on above  
Section Flat

Name of Conservation Agent who supervised plugging of this well *Mr Alexander*  
Producing formation *None* Depth to top Bottom Total Depth of Well *4095* Feet

Show depth and thickness of all water, oil and gas formations.

OIL, GAS OR WATER RECORDS


CASING RECORD

Formation	Content	From	To	Size	Put In	Pulled Out
				<i>10 3/4</i>	<i>250</i>	<i>None</i>

Describe in detail the manner in which the well was plugged, indicating where the mud fluid was placed and the method or methods used in introducing it into the hold. If cement or other plugs were used, state the character of same and depth placed, from feet to feet for each plug set.

*Hole filled with 10.8# mud plug at 250 15 sacks of cement on plug filled with mud to within 10 ft of bottom of cellar plug placed there filled with cement to bottom of cellar.*

PLUGGING  
FILE NO. *15123 R 15W*  
BOOK PAGE *46* LINE *23*

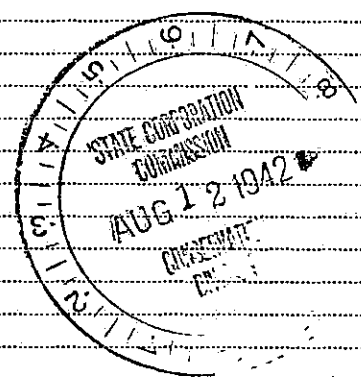

(If additional description is necessary, use BACK of this sheet)  
Correspondence regarding this well should be addressed to *Herndon Sulg Co.*  
Address *Julia, Oklahoma Box 1565*

STATE OF *Kansas*, COUNTY OF *Sedgewick*, ss.  
*Wm. G. Rather* (employee of owner) or (owner or operator) of the above-described well,

being first duly sworn on oath, says: That I have knowledge of the facts, statements, and matters herein contained and the log of the above-described well as filed and that the same are true and correct. So help me God

(Signature) *W. G. Rather*

*Lyons, Kans.*  
(Address)

SUBSCRIBED AND SWORN to before me this *11th* day of *August*, 19 *42*

*O. R. Chappell*  
Notary Public.

My commission expires *11/15/43*

15.145-01286-0000

FAIN DRIG.CO.  
 Singer No. 1.

SEC.1 T.23 R. 15 W  
 SWc SE

Total Depth. 4095'  
 Comm. 7-9-42 Comp. 8-7-42  
 Shot or Treated.  
 Contractor.  
 Issued. 8-22-42

County. Pawnee



CASING:  
 10 3/4" 249' Cemented

Elevation.

Production. Dry

Figures Indicate Bottom of Formations.

top Kelly Drivers	
bot. cellar	11
surface soil & shale	70
sand	90
shale & shells	330
shale & red rock	385
sand	450
shale & red rock	520
sand & stks shale	930
anhydrite	980
shale & shells	1490
shale & lime shells	1660
shale & shells	1790
lime & shale	2045
lime	2065
sand	2080
shale & shells	2130
lime brkn	2174
sand	2190
lime	2232
shale & shells	2265
lime	2305
lime brkn	2335
lime & shells	2415
lime	2550
shale	2565
lime	2708
shale	2735
shale & shells	2860
shale & lime shells	2945
shale & shells	3045
shale	3070
lime	3120
lime & shale	3245
lime	3480
lime brkn	3545
lime	3865
lime & shale	3915
shale & shells	3945
lime	3975
chert	4035
shale & lime	4080
lime	4095
Total Depth.	

Arbuckle 4061-95

1 23-15W  
 46 33