

15-145-60221-0000

STATE OF KANSAS  
STATE CORPORATION COMMISSION


WELL PLUGGING RECORD

Give All Information Completely  
Make Required Affidavit  
Mail or Deliver Report to:  
Conservation Division  
State Corporation Commission  
800 Biting Building  
Wichita, Kansas

Pawnee County, Sec. 1 Twp. 23S Rge. (E) 15(W)

Location as "NE/CNWxSWx" or footage from lines NE SW SW  
Lease Owner Natural Gas & Oil Co., A div. of Miss. River Fuel  
Lease Name McComas Well No. 1 Corp.  
Office Address 1009 Central Building, Wichita 2, Kansas  
Character of Well (completed as Oil, Gas or Dry Hole) dry hole  
Date well completed July 2, 1954 19  
Application for plugging filed July 3, 1954 (orally) 19  
Application for plugging approved July 3, 1954 19  
Plugging commenced July 3, 1954 19  
Plugging completed July 3, 1954 19  
Reason for abandonment of well or producing formation

NORTH

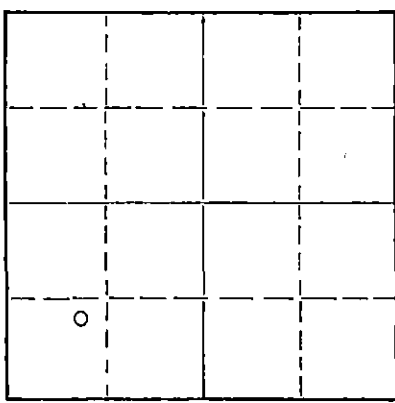

Locate well correctly on above Section Plat

If a producing well is abandoned, date of last production 19  
Was permission obtained from the Conservation Division or its agents before plugging was commenced? yes

Name of Conservation Agent who supervised plugging of this well M. A. Rives, Pratt, Kansas  
Producing formation Depth to top Bottom Total Depth of Well Feet  
Show depth and thickness of all water, oil and gas formations.

OIL, GAS OR WATER RECORDS

CASING RECORD

FORMATION	CONTENT	FROM	TO	SIZE	PUT IN	PULLED OUT
Surface		0	200	8 5/8"	200	none

Describe in detail the manner in which the well was plugged, indicating where the mud fluid was placed and the method or methods used in introducing it into the hole. If cement or other plugs were used, state the character of same and depth placed, from feet to feet for each plug set.

Filled hole with heavy mud from 4086 T.D. to 200 feet  
Set plug at 200 feet and ran 20 sacks cement to 150 feet  
Filled hole with heavy mud from 150 to 35 feet  
Set plug at 35 feet and capped with 10 sacks cement.

7-9-54

(If additional description is necessary, use BACK of this sheet)

Name of Plugging Contractor Harms-Burt Drilling Company  
Address P O Box 184, Pratt, Kansas


STATE OF Kansas, COUNTY OF Sedgwick, ss.  
John D. Carey (employee of owner) or (owner/producer) of the above-described well, being first duly sworn on oath, says: That I have knowledge of the facts, statements, and matters herein contained and the log of the above-described well as filed and that the same are true and correct. So help me God.

(Signature) John D. Carey  
1009 Central Building - Wichita, Kansas (Address)

SUBSCRIBED AND SWORN TO before me this 8th day of July, 1954

Esther Unsell  
Notary Public.

My commission expires May 25, 1957

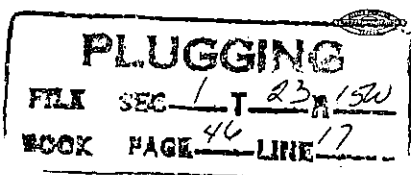

DRILLER'S LOG

15-145-00221-0000

COMPANY: Natural Gas and Oil Company, a division of Mississippi River Fuel Corporation, etal

FARM: McComas #1, NE SW SW Sec. 1-23S-15W, Pawnee County, Kansas

COMMENCED: June 22, 1954

COMPLETED: July 3, 1954

CONTRACTOR: Harms-Burt Drilling Company

ELEVATION: 1991 RB.

0	to	40	Clay and sand
40	to	110	Sand
110	to	390	Shale and shells
390	to	580	Red bed and sand
580	to	926	Red bed
926	to	951	Anhydrite
951	to	1650	Shale, salt and shells
1650	to	1800	Shale and shells
1800	to	1960	Shale and lime
1960	to	2135	Lime
2135	to	3460	Lime and shale
3460	to	3580	Shale and sand
3580	to	3595	Lime and shale
3595	to	3665	Lime
3665	to	3792	Lime and shale
3792	to	3845	Lime
3845	to	3945	Lime and shale
3945	to	3980	Lime, shale and chert
3980	to	3995	Chert
3995	to	4020	Lime
4020	to	4051	Shale
4051	to	4086	Lime
		4086	T. D.

Set 200 feet of 8 5/8" 24# surface pipe. Cemented with 200 sacks cement and 4 sacks calcium chloride.

TOPS:	Anhydrite	926	Schlumberger tops	
	Heebner	3440	Heebner	3438
	Brn Lime	3577	Brn Lime	3576
	Lansing	3591	Lansing	3590
	B/ KC.	3832		
	Viola	3939	Viola	3944
	Simpson	4012	Simpson	3994
			Arbuckle	4046

RECEIVED  
COMMISSION DIVISION  
JUL 2 - 1954

No drillstem tests. Ran Schlumberger  
DRY, PLUGGED AND ABANDONED

c e r t i f i c a t e

I, John D. Carey, do hereby certify that the above and foregoing is a true and correct copy of the log of the McComas #1, NE SW SW Section 1-23S-15W, Pawnee County, Kansas, as reflected by files of the Natural Gas and Oil Company, a division of Mississippi River Fuel Corporation,

**PLUGGING**  
FILE SEC 1 T 23 R 15W  
BOOK PAGE 46 LINE 17

*John D. Carey*  
John D. Carey,  
Exploration and Land Manager

Subscribed and sworn to before me, a Notary Public, within and for Sedgwick County, Kansas, this 8th day of July, 1954.

*Esther Unsell*  
Esther Unsell, Notary Public

My commission expires May 25, 1957