


15-145-80162-000

WELL PLUGGING RECORD

Give All Information Completely  
Make Reg. Affidavit  
Mail or Deliver Report to:  
Conservation Division  
State Corporation Commission  
800 Bittling Building  
Wichita, Kansas

Pawnee County. Sec. 1 Twp. 23 Rge. (E) 15 (W)  
Location as "NE/CNW $\frac{1}{4}$ /SW $\frac{1}{4}$ " or footage from lines NE SE NW  
Lease Owner Westgate-Greenland Oil Company  
Lease Name Wiles Well No. 1  
Office Address 1009 Central Building, Wichita 2, Kansas  
Character of Well (completed as Oil, Gas or Dry Hole) dry hole  
Date well completed August 15, 1951 19  
Application for plugging filed August 15, 1951 19  
Application for plugging approved August 15, 1951 19  
Plugging commenced August 15, 1951 19  
Plugging completed August 15, 1951 19  
Reason for abandonment of well or producing formation.....

NORTH

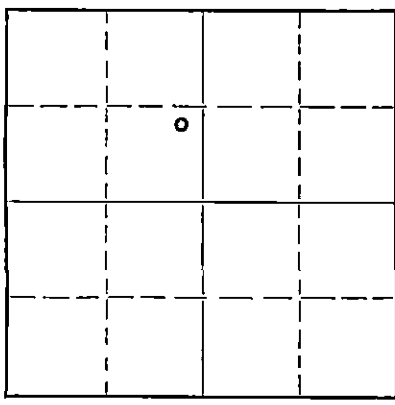

Locate well correctly on above Section Plat

If a producing well is abandoned, date of last production..... 19  
Was permission obtained from the Conservation Division or its agents before plugging was commenced? yes

Name of Conservation Agent who supervised plugging of this well.....  
Producing formation..... Depth to top..... Bottom..... Total Depth of Well..... Feet  
Show depth and thickness of all water, oil and gas formations.

OIL, GAS OR WATER RECORDS

CASING RECORD

Formation	Content	From	To	Size	Put In	Pulled Out
Surface		0	306	8 5/8"	306	none

Describe in detail the manner in which the well was plugged, indicating where the mud fluid was placed and the method or methods used in introducing it into the hole. If cement or other plugs were used, state the character of same and depth placed, from..... feet to..... feet for each plug set.

Filled hole with heavy mud from total depth of 4055 feet to 250 feet  
Set Lane-Wells plug at 250 feet and ran 15 sack cement to 210 feet  
Filled with heavy mud from 210 feet to 35 feet  
Set plug at 35 feet and ran 10 sacks cement to cellar base.

RECEIVED  
STATE CORPORATION COMMISSION  
AUG 17 1951 8-17-51

CONSERVATION DIVISION  
Wichita, Kansas

(If additional description is necessary, use BACK of this slip)  
Correspondence regarding this well should be addressed to Westgate-Greenland Oil Company  
Address 1009 Central Building, Wichita 2, Kansas

STATE OF Kansas, COUNTY OF Sedgwick, ss.  
Harold A. Burt (employee of owner) or (owner or operator) of the above-described well,

being first duly sworn on oath, says: That I have knowledge of the facts, statements, and matters herein contained and the log of the above-described well as filed and that the same are true and correct. So help me God.

(Signature) Harold A. Burt  
1009 Central Building, Wichita 2, Kansas  
(Address)

SUBSCRIBED AND SWORN TO before me this 16th day of August, 19 51  
Esther Russell  
Notary Public.

My commission expires May 25, 1953.

PLUGGING  
FILE SEC-1-23-R/Sw  
BOOK PAGE 103 LINE 16

15-145-00162-000

DRILLERS LOG

COMPANY: Westgate-Greenland Oil Company  
 CONTRACTOR: Jackson Drilling Corporation  
 FARM: Wiles No. 1  
 LOCATION: NE SE NW Sec. 1-23-15W,  
 Pawnee County, Kansas  
 COMMENCED: August 3, 1951  
 COMPLETED: August 15, 1951  
 ELEVATION: 1989 DF

0	to	108	Sand
108	to	307	Shale
307	to	400	Shale and red bed
400	to	470	Sand
470	to	939	Red bed
939	to	963	Anhydrite
963	to	1365	Shale and shells
1365	to	1560	Shale and salt
1560	to	1725	Shale and shells
1725	to	1830	Shale and lime
1830	to	2300	Lime
2300	to	2900	Shale and lime
2900	to	2935	Lime
2935	to	3205	Shale and lime
3205	to	3265	Lime
3265	to	3586	Lime and shale
3586	to	3635	Lime
3635	to	3688	Lime w/chert streaks
3688	to	3720	K. C. Lime
3720	to	3820	Lime
3820	to	3911	Lime and shale
3911	to	3917	Shale
3917	to	3957	Conglomerate
3957	to	3995	Viola
3995	to	4025	Shale
4025	to	4050	Shale and lime
4050	to	4055	Arbuckle
		4055	T. D.

Set 306 feet 8 5/8" surface pipe. Cemented with 225 sacks cement and 3 sacks calcium chloride.

Drillstem test: 4046-54, open 1 hour, rec. 300 feet salt water with BHP of 1200#.

TOPS: Anhydrite 939. Lansing 3584 Viola 3955  
 Heebner 3441 B/K.C. 3825 Simpson 3993  
 Brn Ls 3572. Chert Cong 3922. Re-Arb 4023

Dry, plugged and abandoned

RECEIVED  
 STATE COMMISSION COMM'

C E R T I F I C A T E AUG 17 1951

I, Harold A. Burt, do hereby certify that the above and foregoing is a true and correct copy of log of Wiles No. 1, Section 1-23-15W, Pawnee County, Kansas, as reflected by files of the Jackson Drilling Corporation.

*Harold A. Burt*  
 Harold A. Burt

Subscribed and sworn to before me, a Notary Public, within and for Sedgwick County, Kansas, this 16th day of August, 1951.

*Esther Burt*  
 Notary Public

My commission expires May 25, 1953.

**PLUGGING**  
 FILE SEC 1 T23 R/SW  
 BOOK PAGE 123 LINE 16