

STATE OF KANSAS
STATE CORPORATION COMMISSION


15-445-20828-0000

WELL PLUGGING RECORD

Give All Information Completely
Make Required Affidavit
Mail or Deliver Report to
Conservation Division
State Corporation Comm.
245 North Water
Wichita, KS 67202

Pawnee County, Sec. 2 Twp. 23S Rge. 15W E/W
Location as "NE/CNW $\frac{1}{4}$ SW $\frac{1}{4}$ " or footage from lines
SW NE NE

Lease Owner Lee Phillips Oil Co.
Lease Name Seibert Well No. 1
Office Address 25 N. Market Suite 1532 Wichita, Kansas 67202
Character of Well (Completed as Oil, Gas or Dry Hole)
Dry Hole

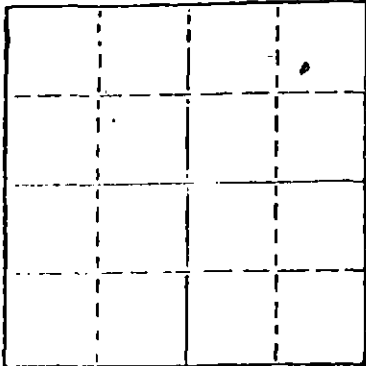

Locate well correctly on above
Section Plat

Date Well completed 3-12-81 19
Application for plugging filed 3-12-81 19
Application for plugging approved 3-12-81 19
Plugging commenced 3-12-81 19
Plugging completed 3-13-81 19
Reason for abandonment of well or producing formation

If a producing well is abandoned, date of last production 19

Was permission obtained from the Conservation Division or
its agents before plugging was commenced? Yes

Name of Conservation Agent who supervised plugging of this well Schmidt
Producing formation Depth to top Bottom Total Depth of Well 4070
Show depth and thickness of all water, oil and gas formations.

OIL, GAS OR WATER RECORDS

CASING RECORD

FORMATION	CONTENT	FROM	TO	SIZE	PUT IN	PULLED OUT

Describe in detail the manner in which the well was plugged, indicating where the mud fluid
was placed and the method or methods used in introducing it into the hold. If cement or other
plugs were used, state the character of same and depth placed, from feet to
feet for each plug set.

Mud To 600' 65 Sacks 50-50 Posmix 4%Gel
Mud To 210' 30 Sacks 50-50 Posmix 4%Gel
Mud To 40' 10 Sacks 50-50 Posmix 4%Gel
Rat Hole 5 Sacks 50-50- Posmix 4%Gel

RECEIVED
STATE CORPORATION COMMISSION

(If additional description is necessary, use BACK of this sheet)

Name of Plugging Contractor Merckle Drilling Co. MAR 23 1981

STATE OF Kansas COUNTY OF Barton CONSERVATION DIVISION
Wichita, Kansas
Clyde Merckle (employee of owner) or (owner or operator)

of the above-described well, being first duly sworn on oath, says: That I have knowledge of
the facts, statements, and matters herein contained and the log of the above-described well
as filed and that the same are true and correct. So help me God.

(Signature) Clyde Merckle
Box 1382 Great Bend, Kansas 67530
(Address)

SUBSCRIBED AND SWORN TO before me this 22nd day of March, 1981

Lois L. Barry
Notary Public.

My commission expires 3-28-84



Lee Phillips Oil Co.
125 N. Market Suite 1532
Wichita, Kansas 67202

15-145-20828.0000

Seibert #1


SW NE NE

Section 2 Twp. 23S Rge. 15W

Pawnee County

Driller's Log _____ Total Depth 4070

0-----150 Sand
150----385 Red Bed & Shale
385---938 Red Bed & Shale
938----960 Anhydrite
960----1840 Shale & Lime
1840---2055 Shale & Lime
2055---2900 Lime & Shale
2900---3535 Lime & Shale
3535---3750 Lime & Shale
3750---4070 Lime


Clyde Merckle