


WELL PLUGGING RECORD

Give All Information Completely
Make Required Affidavit
Mail or Deliver Report to:
Conservation Division
State Corporation Commission
211 No. Broadway
Wichita, Ka.

Pawnee County, Sec. 3 Twp. 23S Rge. 15 (W)

Location as "NE/CNW/SW" or footage from lines NW NW NW
Lease Owner Brunson-Spines
Lease Name Guffey Well No. 1
Office Address 333 First Nat'l. Bank Bldg., Wichita, Ks.
Character of Well (completed as Oil, Gas or Dry Hole) Dry hole
Date well completed 7-8 1958
Application for plugging filed 7-8 1958
Application for plugging approved 7-8 1958
Plugging commenced 7-8 1958
Plugging completed 7-8 1958
Reason for abandonment of well or producing formation Dry hole

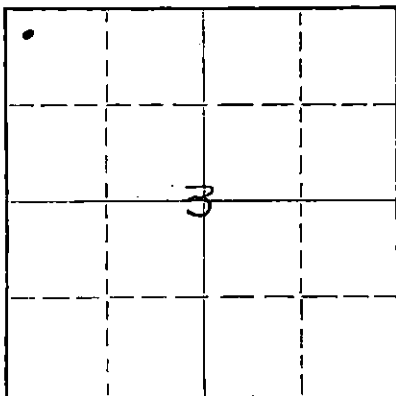

Locate well correctly on above Section Plat

If a producing well is abandoned, date of last production 19
Was permission obtained from the Conservation Division or its agents before plugging was commenced? Yes

Name of Conservation Agent who supervised plugging of this well Eldon Petty
Producing formation _____ Depth to top _____ Bottom _____ Total Depth of Well 3975 Feet
Show depth and thickness of all water, oil and gas formations.

OIL, GAS OR WATER RECORDS

CASING RECORD

FORMATION	CONTENT	FROM	TO	SIZE	PUT IN	PULLED OUT
				8-5/8"	268'	none

Describe in detail the manner in which the well was plugged, indicating where the mud fluid was placed and the method or methods used in introducing it into the hole. If cement or other plugs were used, state the character of same and depth placed, from _____ feet to _____ feet for each plug set.

Hole circulated with heavy mud, then drill pipe laid down.

Filled hole with mud. Pushed plug to 250', covered with

20 sacks cement and 1/2 sack hulls, through 8 jts. drill

pipe. Remainder of drill pipe laid down and hole filled

to within 40' of top. Pushed plug to 40'. Covered with

10 sacks cement and 1/2 sack hulls. Plugs secured with

2 strands of .066 HOWCO steel line.

(If additional description is necessary, use BACK of this sheet)

Name of Plugging Contractor Brunson Production & Exploration, Inc.,
Address 333 First National Bank Bldg., Wichita, Kansas

STATE OF KANSAS, COUNTY OF SEDGWICK, ss.
Ralph B. McLaughlin (employee of owner) of the above-described well, being first duly sworn on oath, says: That I have knowledge of the facts, statements, and matters herein contained and the log of the above-described well as filed and that the same are true and correct. So help me God.

(Signature) Ralph B. McLaughlin
Ralph B. McLaughlin
333 First Nat'l. Bank Bldg., Wichita,
(Address)

SUBSCRIBED AND SWORN TO before me this 29th day of July, 1958

My commission expires June 16, 1959

Mary G. LaFollette
Mary G. LaFollette
Notary Public.

PLUGGING
FILE SEC. 3 T23 R15W
BOOK PAGE 116 LINE 4

AUG 5 1958
CONSERVATION DIVISION
8-5-58

BRUNSON-SPINES
WICHITA, KANSAS

15-145-10094-0000

WELL: GUFFEY #1

NW NW NW

COMMENCED RD: 6-28-58

3-23S-15W

COMPLETED RD: 7- 8-58

PAWNEE COUNTY

TOTAL DEPTH: 3975'

ELEVATION: 2009 KB

CASING: 268' - 8-5/8"

CONTRACTOR: Brunson Prod. & Explor.

STRATA	DEPTH	TOPS
Sand	195	Heebner Shale 3415 (-1406)
Shale	350	Douglas Shale 3448 (-1439)
Red Bed	422	Brown Lime 3535 (-1526)
Sand	480	Lansing 3544 (-1535)
Red Bed	580	Viola 3871 (-1861)
Red Bed & Streaks of Sand	935	Simpson Shale 3926 (-1917)
Anhydrite	960	Simpson Sand 3953 (-1944)
Shale & Shells	1385	Total Depth 3975 (-1966)
Shale, clay & red bed	1490	
Salt & Shale	1570	
Shale & Lime	1670	
Shale	1800	
Lime & Shale	1825	
Lime	2070	
Lime & Shale	3345	
Lime	3840	
Lime & Shale	3903	
Chert & Lime	3929	
Lime & Sand	3969	
Lime & Chert	3975	
T. D.	3975	

D & A

I hereby certify that the above is a true and correct log of said well as reflected by the daily drilling report.

BRUNSON-SPINES

Ralph B. McLaughlin
Ralph B. McLaughlin

Signed and sworn to in my presence this 29th day of July, 1958, by Ralph B. McLaughlin, of Brunson-Spines.

Mary G. LaFollette
Mary G. LaFollette, Notary Public

My commission expires June 16, 1959.

PLUGGING		
FILE	SEC 3	T-23 RISW
BOOK	PAGE 16	LINE 4

RECEIVED
STATE CORPORATION COMMISSION

AUG 5 1958

CONSERVATION DIVISION
Wichita, Kansas