


15.145-19045-0000

STATE OF KANSAS
STATE CORPORATION COMMISSION

WELL PLUGGING RECORD

Give All Information Completely
Make Required Affidavit
Mail or Deliver Report to:
Conservation Division
State Corporation Commission
800 Fitting Building
Wichita, Kansas

NORTH

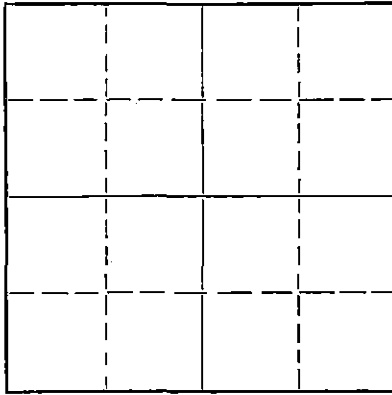

Locate well correctly on above
Section Plat

Pawnee County, Sec. 3 Twp. 23S Rge. XXI5 (W)
Location as "NE/CNW/SW" or footage from lines 330' fr. W, 990' fr. North, NW/4
Lease Owner Phillips Petroleum Company
Lease Name Guffey "A" Well No. 2
Office Address Box 779, Great Bend, Kansas
Character of Well (completed as Oil, Gas or Dry Hole) Lost surface csg. in hole.
Date well completed 4-17-55 19__
Application for plugging filed 4-18-55 19__
Application for plugging approved 4-19-55 19__
Plugging commenced 4-17-55 19__
Plugging completed 4-17-55 19__
Reason for abandonment of well or producing formation Lost surface csg. in hole

If a producing well is abandoned, date of last production - 19__
Was permission obtained from the Conservation Division or its agents before plugging was commenced? Yes

Name of Conservation Agent who supervised plugging of this well Warren Horner
Producing formation NR Depth to top - Bottom - Total Depth of Well 2665 Feet
Show depth and thickness of all water, oil and gas formations.

OIL, GAS OR WATER RECORDS

CASING RECORD

FORMATION	CONTENT	FROM	TO	SIZE	PUT IN	PULLED OUT
No Record				9-5/8"	564.21	None

Describe in detail the manner in which the well was plugged, indicating where the mud fluid was placed and the method or methods used in introducing it into the hole. If cement or other plugs were used, state the character of same and depth placed, from _____ feet to _____ feet for each plug set.

Mudded hole from 2665' to 300'. Pushed Howco 9-5/8" plug to 300'. Dumped 30 sx. hulls. Pumped down 20 sx. cement. Mudded hole to 30'. Pushed 9-5/8" plug to 30'. Dumped 1/3 sack hulls and 15 sx. cement to surface. Well plugged and abandoned 10:30 P.M. 4-17-55.

(If additional description is necessary, use BACK of this sheet)

Name of Plugging Contractor Phillips Petroleum Company
Address Oklahoma City, Oklahoma

STATE OF Kansas, COUNTY OF Barton, ss.

A. J. Willis (employee of owner) ~~SEVERAL OPERATOR~~ of the above-described well, being first duly sworn on oath, says: That I have knowledge of the facts, statements, and matters herein contained and the log of the above-described well as filed and that the same are true and correct. So help me God.

(Signature) A. J. Willis

Box 779, Great Bend, Kansas
(Address)

SUBSCRIBED AND SWORN TO before me this 20th day of April, 19 55

My commission expires November 18, 1957

Joseph H. [Signature]
Notary Public.

24-7368-S 3-93-20M

PLUGGING
FILED SEC 3 T 23 R 15 W
BOOK PAGE 113 LINE 6

APR 22 1955
CONSERVATION DIVISION
Wichita, Kansas

4-22-55

15.145.19045-0000

EXPLORATION RECORD

Phillips Petroleum Company - 330' from West Line and
990' from North Line, NW/4 Sec. 3-23S-15W, Pawnee
County, Kansas
Mickey #1

Lease

Well **2**

Formation Name	Top	Base	Remarks
Sand	0	130	
Sand, clay, and Redbed	130	490	
Redbed	490	576	
Redbed, shells, and anhydrite	576	1042	
Shale, shells and salt	1042	1544	
Shale, salt, sand, and lime	1544	1832	
Lime and shale	1832	1985	
Lime	1985	2272	
Lime and shale	2272	2587	
Lime	2587	2665	

Not penetrated at 2665' TD.

RECEIVED
OIL AND GAS COMMISSION
APR 22 1955
EXPLORATION DIVISION
Wichita, Kansas

PLUGGING
FILE SEC 3 T 23 R 15W
BOOK PAGE 113 LINE 6