


Give All Information Completely
Make Required Affidavit
Mail or Deliver Report to:
Conservation Division
State Corporation Commission
211 No. Broadway
Wichita, Kansas

WELL PLUGGING RECORD

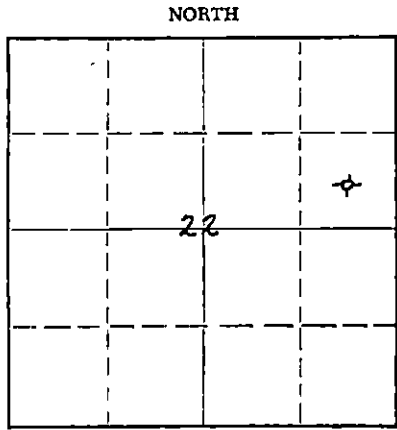

Locate well correctly on above
Section Plat

McPherson County, Sec. 22 Twp. 21S Rge. 4W (~~XXXXXX~~)
Location as "NE/CNW/SW" or footage from lines C SE NE
Lease Owner Mayfield-Smith Drilling, Inc., et al
Lease Name DuBois Well No. 1
Office Address 928 Union Center Bldg., Wichita, Kansas
Character of Well (completed as Oil, Gas or Dry Hole) Dry Hole
Date well completed May 16, 1965
Application for plugging filed May 16 19 65
Application for plugging approved May 16 19 65
Plugging commenced May 16 19 65
Plugging completed May 16 19 65
Reason for abandonment of well or producing formation,
Oil in commercial quantities not found.
If a producing well is abandoned, date of last production - - - 19 -
Was permission obtained from the Conservation Division or its agents before plugging was commenced? Yes

Name of Conservation Agent who supervised plugging of this well Gilbert Toman, Holyrood, Kansas
Producing formation - - - Depth to top - - Bottom - - Total Depth of Well 3861 Feet
Show depth and thickness of all water, oil and gas formations.

OIL, GAS OR WATER RECORDS

CASING RECORD

FORMATION	CONTENT	FROM	TO	SIZE	PUT IN	PULLED OUT
				8 5/8"	590'	None

Describe in detail the manner in which the well was plugged, indicating where the mud fluid was placed and the method or methods used in introducing it into the hole. If cement or other plugs were used, state the character of same and depth placed, from _____ feet to _____ feet for each plug set.

Filled hole with heavy rotary mud to 555'. Set #1 Plug @ 555' with 1/4 Sack of Hulls, 20 Sks. Cement. Second Plug @ 200' with 1/4 Sk. Hulls, 20 Sks. Cement. Top plug @ 40' with 1/2 Sk. Hulls, 10 Sks. Cement.

RECEIVED
STATE CORPORATION COMMISSION
JUN 11 1965
CONSERVATION DIVISION
Wichita, Kansas

7-11-65

(If additional description is necessary, use BACK of this sheet)
Name of Plugging Contractor Mayfield-Smith Drilling, Inc.
Address 928 Union Center, Bldg., Wichita, Kansas

STATE OF Kansas, COUNTY OF Sedgwick, ss.
Edgar E. Smith (employee of owner) or (owner or operator) of the above-described well, being first duly sworn on oath, says: That I have knowledge of the facts, statements, and matters herein contained and the log of the above-described well as filed and that the same are true and correct. So help me God.

(Signature) Edgar E. Smith
928 Union Center Bldg., Wichita, Kansas
(Address)

Subscribed and Sworn to before me this 2nd day of June, 19 65
Marguerite Mayfield
Notary Public.

