


Give All Information Completely
Make Required Affidavit
Mail or Deliver Report to:
Conservation Division
State Corporation Commission
800 Biting Building
Wichita, Kansas

WELL PLUGGING RECORD

McPherson County. Sec. 21 Twp. 21S Rge. 4W ~~XXX~~ (W)

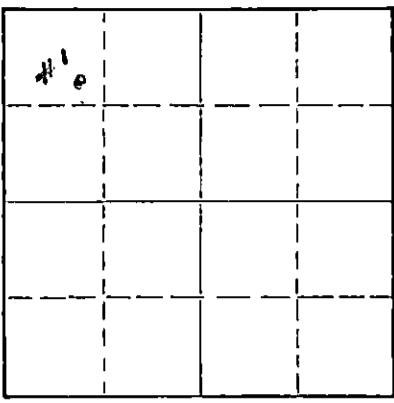

Locate well correctly on above Section Plat

Location as "NE/CNW/SW" or footage from lines SE NW NW
Lease Owner Sinclair Oil & Gas Company
Lease Name John H. Klassen Well No. 1
Office Address P. O. Box 521, Tulsa, Oklahoma
Character of Well (completed as Oil, Gas or Dry Hole) Dry Hole
Date well completed October 19, 19 55
Application for plugging filed October 19, 19 55
Application for plugging approved October 20, 19 55
Plugging commenced October 20, 19 55
Plugging completed October 20, 19 55
Reason for abandonment of well or producing formation Dry hole.

If a producing well is abandoned, date of last production Dry hole. 19
Was permission obtained from the Conservation Division or its agents before plugging was commenced? Yes

Name of Conservation Agent who supervised plugging of this well Ruel Durkee
Producing formation None Depth to top _____ Bottom _____ Total Depth of Well 4009 Feet
Show depth and thickness of all water, oil and gas formations.

OIL, GAS OR WATER RECORDS

CASING RECORD

FORMATION	CONTENT	FROM	TO	SIZE	PUT IN	PULLED OUT
None				10-3/4"	513'	None

Describe in detail the manner in which the well was plugged, indicating where the mud fluid was placed and the method or methods used in introducing it into the hole. If cement or other plugs were used, state the character of same and depth placed, from _____ feet to _____ feet for each plug set.

Mudded hole from 4009' to 250'
Halliburton bridge plug 250' to 249'.
Cemented from 249' to 170'.
Mudded hole from 170' to 35'.
Cemented from 35' to 0'.

Conservation Division
Wichita, Kansas

11-9-55

(If additional description is necessary, use BACK of this sheet)
Name of Plugging Contractor Brack Drilling Company
Address 309-10 Brown Building, Wichita, Kansas

STATE OF Kansas, COUNTY OF Rice, ss.
W. B. Rhees (employee of owner) or ~~owner or operator~~ of the above-described well, being first duly sworn on oath, says: That I have knowledge of the facts, statements, and matters herein contained and the log of the above-described well as filed and that the same are true and correct. So help me God.

(Signature) W. B. Rhees
Chase, Kansas (Address)

SUBSCRIBED AND SWORN TO before me this 7th day of Nov., 1955

My commission expires April 24-1956 Notary Public.

PLUGGING
FILE SEC 21 T 21 R 4W
BOOK PAGE 2 LINE 23

BRACK DRILLING COMPANY, INC.
309-10 BROWN BUILDING
WICHITA 2, KANSAS

JOHN H. KLASSEN #1

990' S from N line &
990' E from W line

NW/4 Sec. 21-21S-4W
McPherson County, Kansas
Commenced: 9-30-55
Completed: 10-20-55

TOTAL DEPTH: 4009'

WELL LOG

Shale & Sand	0 -	275'
Shale & Shells		571
Lime & Shale		1215
Lime		1250
Shale		1445
Shale & Lime		1640
Lime & Shale		2000
Shale & Lime		2135
Lime & Shale		2260
Lime		2340
Lime & Shale		2440
Shale & Shells		2600
Shale & Lime		2643
Lime & Shale		2910
Shale & Lime		2953
Lime		3079
Lime & Shale		3220
Shale & Lime		3283
Lime & Shale		3558
Lime		3585
Lime & Shale		3601
Lime		3611
Shale & Lime		3816
Shale		3978
Lime & Shale		4009' T.D. D & A

The above depths denote bottom of formations.

CASING

10 3/4" 513'

To the best of my knowledge, the above is a true and correct statement of the depths and formations and where found.

BRACK DRILLING COMPANY, INC.

By *Paul F. Brack*

WITNESSED:

Arthur C. ...

October 21, 1955.

STATE OF KANSAS
NOV - 9 1955
CONSERVATION DIVISION
Wichita, Kansas

PLUGGING
FILE SEC 21 T 21 R 4 W
BOOK PAGE 9 LINE 33