


STATE OF KANSAS
STATE CORPORATION COMMISSION

WELL PLUGGING RECORD

Give All Information Completely
Make Required Affidavit
Mail or Deliver Report to:
Conservation Division
State Corporation Commission
211 No. Broadway
Wichita, Kansas

McPherson County, Sec. 19 Twp. 21 Rge. (E) 24 (W)
Location as "NE/CNW/SW" or footage from lines NW NW NW
Lease Owner Earl F. Wakefield
Lease Name Plett Well No. 1
Office Address 515 Union Center Bldg., Wichita, Kansas
Character of Well (completed as Oil, Gas or Dry Hole) Dry Hole
Date well completed January 9 19 57
Application for plugging filed January 9 19 57
Application for plugging approved January 9 19 57
Plugging commenced January 9 19 57
Plugging completed January 9 19 57
Reason for abandonment of well or producing formation

NORTH

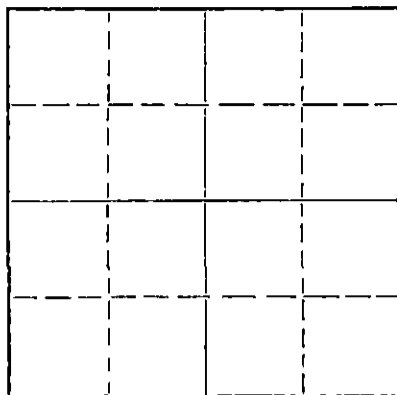

Locate well correctly on above
Section Flat

If a producing well is abandoned, date of last production 19
Was permission obtained from the Conservation Division or its agents before plugging was commenced? Yes

Name of Conservation Agent who supervised plugging of this well Ruel Durkee
Producing formation Depth to top Bottom Total Depth of Well 4075 Feet
Show depth and thickness of all water, oil and gas formations.

OIL, GAS OR WATER RECORDS

CASING RECORD

| FORMATION | CONTENT | FROM | TO | SIZE | PUT IN | PULLED OUT |
|-----------|---------|------|----|--------|--------|------------|
| | | | | 8 5/8" | 140' | None |
| | | | | | | |
| | | | | | | |
| | | | | | | |
| | | | | | | |
| | | | | | | |
| | | | | | | |
| | | | | | | |
| | | | | | | |

Describe in detail the manner in which the well was plugged, indicating where the mud fluid was placed and the method or methods used in introducing it into the hole. If cement or other plugs were used, state the character of same and depth placed, from feet to feet for each plug set.

Hole filled with heavy mud to 160'
Plug set W/1 1/2 sk hulls cemented W/
15 sks cement, top plug set @ 40' W/
10 sks cement

1-21-57

RECEIVED
STATE CORPORATION COMMISSION

Name of Plugging Contractor Earl F. Wakefield (If additional description is necessary, use BACK of this sheet)
Address 515 Union Center Building
JAN 21 1957
CONSERVATION DIVISION
Wichita, Kansas

STATE OF KANSAS, COUNTY OF SEDGWICK, ss.
Earl F. Wakefield (Employer or owner or operator) of the above-described well, being first duly sworn on oath, says: That I have knowledge of the facts, statements, and matters herein contained and the log of the above-described well as filed and that the same are true and correct. So help me God.

(Signature) Earl F. Wakefield
515 Union Center Building
(Address)

SUBSCRIBED AND SWORN to before me this 18th day of January, 1957

My commission expires July 26, 1958 C. A. Snow Notary Public.

PLUGGING
FILE SEC 19 T 21 R 4W
BOOK PAGE 132 LI 39

LEASE: Plett #1
 OPERATOR: Earl F. Wakefield
 CONTRACTOR: Earl F. Wakefield
 COMM: 12-26-56 COMP: 1-9-57

LOCATION: NW NW NW 19-21S-24W
 McPherson County, Kansas
 CASING: 8 5/8" Set @ 140'

Elevation: 1530 G.L.

| | |
|---------------|------|
| Surface | 140 |
| Shale | 560 |
| Salt | 725 |
| Salt & Shale | 745 |
| Shale & Lime | 2390 |
| Lime | 2530 |
| Sand & Lime | 2718 |
| Lime | 3256 |
| Lime & Shale | 3350 |
| Conglomerate | 3435 |
| Lime | 3545 |
| Lime, Cherty | 3585 |
| Lime | 3666 |
| Shale | 3782 |
| Sand & Shale | 3790 |
| Shale | 3874 |
| Shale & Lime | 3954 |
| Sand, Simpson | 3965 |
| Lime & Sand | 4030 |
| Lime | 4062 |
| Lime & Chert | 4075 |
| T.R.D. | 4075 |

STATE OF KANSAS)
) SS
 COUNTY OF SEDGWICK)

I hereby agree and certify that the above is a true and correct copy of the log on the Plett #1 well located NW NW NW 19-21S-24W, McPherson County, Kansas.

Earl F. Wakefield
RECEIVED
 STATE CORPORATION COMMISSION
 Sworn and subscribed before me this 18th day of January, 1957
 JAN 2 1957
 CONSERVATION DIVISION
 Wichita, Kansas
[Signature]

My Commission Expires: July 26, 1958

PLUGGING
 FILE NO. 19 T. 21 R. 4W
 BOOK PAGE 132 LI E. 39