


STATE OF KANSAS  
STATE CORPORATION COMMISSION  
200 Colorado Derby Bldg.  
Wichita, Kansas 67202

WELL PLUGGING RECORD

Give All Information Completely  
Make Required Affidavit

COUNTY McPherson SEC. 16 TWP. 21 RGE. 4 ~~E/W~~ <sup>W</sup>  
Location as in quarters or footage from lines:  
NW NW SW

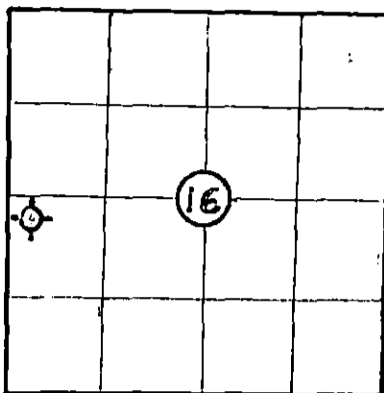

Locate Well  
correctly on above  
Section Platt.

Lease Owner R. J. Walker Oil Co., Inc.  
Lease Name J. Friesen Trust Well No. 1-16  
Office Address 3524 NW 56th St. Okla. City, Okla. 73112  
Character of Well (Completed as Oil, Gas or Dry Hole): Dry Hole  
Date Well Completed 6-24-83 (c)(L)  
Application for plugging filed 6-24-83  
Plugging commenced 6-24-83  
Plugging completed 6-24-83  
Reason for abandonment of well or producing formation \_\_\_\_\_

D & A

Was permission obtained from the Conservation Division or it's  
Agent's before plugging was commenced? Yes

Name of Conservation Agent who supervised plugging of this well Merlin Unruh  
Producing formation None Depth to top \_\_\_\_\_ bottom \_\_\_\_\_ T.D. 4065'

Show depth and thickness of all water, oil and gas formations.

OIL, GAS OR WATER RECORDS

Casing Record

| Formation | Content | From | To | Size    | Put in | Pulled Out |
|-----------|---------|------|----|---------|--------|------------|
|           |         |      |    | 13 3/8" | 220'   | -0-        |
|           |         |      |    | 8 5/8"  | 684'   | -0-        |
|           |         |      |    |         |        |            |
|           |         |      |    |         |        |            |

Describe in detail the manner in which the well was plugged, indicating where the mud  
fluid was placed and the method or methods used in introducing it into the hold. If cement  
or other plugs were used, state the character of same and depth placed, from \_\_\_\_\_ feet  
to \_\_\_\_\_ feet for each plug set.

30 sax @ 720', 30 sax @ 260', 1/2 sax hulls  
Plug, 10 sax @ 40', 10 sax in RH & MH  
Plugged @ 6:15 PM

(If additional description is necessary, use BACK of this sheet)

Name of Plugging Contractor Kansas Drilling & Well Service, Inc.

STATE OF Oklahoma COUNTY OF Oklahoma, ss.  
O. N. Goode, Jr. (employee of owner) or (owner or operator) of the  
above-described well, being first duly sworn on oath, says: That I have knowledge of the  
facts, statements, and matters herein contained and the log of the above-described well as  
filed and that the same are true and correct. So help me God.

(Signature) [Signature]  
Suite 150, 3524 NW 56 St, OKC OK  
(Address) 73112

SUBSCRIBED AND SWORN TO before me this 15 day of July, 19 83

My Commission expires: February 19th, 1985 [Signature] Notary Public.  
RECEIVED STATE CORPORATION COMMISSION

JUL 19 1983 7-19-83