

STATE OF KANSAS
STATE CORPORATION COMMISSION


Give All Information Completely
Make Required Affidavit
Mail or Deliver Report to:
Conservation Division
State Corporation Commission
211 No. Broadway
Wichita, Kansas

WELL PLUGGING RECORD

McPherson County, Sec. 15 Twp. 21 Rge. (E) 4 (W)

Location as "NE/CNW/SW" or footage from lines SW NE
Lease Owner Donald T. Ingling et al
Lease Name Peter Neufeldt Well No. 1
Office Address 615 First National Bldg., Wichita, Kansas
Character of Well (completed as Oil, Gas or Dry Hole) Dry Hole
Date well completed May 28, 1966
Application for plugging filed May 28, 1966
Application for plugging approved May 28, 1966
Plugging commenced May 28, 1966
Plugging completed May 28, 1966
Reason for abandonment of well or producing formation No production

If a producing well is abandoned, date of last production 19
Was permission obtained from the Conservation Division or its agents before plugging was commenced? Yes

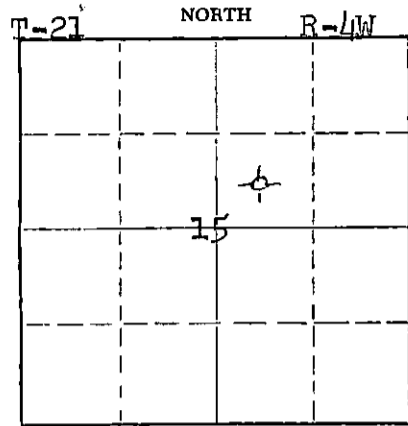

Locate well correctly on above Section Plat

Name of Conservation Agent who supervised plugging of this well Hugh Scott
Producing formation _____ Depth to top _____ Bottom _____ Total Depth of Well 3935 Feet
Show depth and thickness of all water, oil and gas formations.

OIL, GAS OR WATER RECORDS

CASING RECORD

FORMATION	CONTENT	FROM	TO	SIZE	PUT IN	PULLED OUT
				8 5/8"	587'	None

Describe in detail the manner in which the well was plugged, indicating where the mud fluid was placed and the method or methods used in introducing it into the hole. If cement or other plugs were used, state the character of same and depth placed, from _____ feet to _____ feet for each plug set.

Plug at 200 feet and 25 sacks cement then heavy mud to 30 feet then 10 sacks cement and mud to surface - two sacks cement in rat hole

RECEIVED
STATE CORPORATION COMMISSION

JUN - 2 1966

CONSERVATION DIVISION
Wichita, Kansas

(If additional description is necessary, use BACK of this sheet)

Name of Plugging Contractor Donald T. Ingling
Address Wichita, Kansas

STATE OF KANSAS, COUNTY OF SEDGWICK, ss.
D. T. Ingling (employee of owner) or (owner or operator) of the above-described well, being first duly sworn on oath, says: That I have knowledge of the facts, statements, and matters herein contained and the log of the above-described well as filed and that the same are true and correct. So help me God.

(Signature) [Signature]
615 First National Bldg., Wichita, Kans
(Address)

SUBSCRIBED AND SWORN TO before me this 1st day of June, 1966
[Signature]
Notary Public.

My commission expires February 27, 1968

WELL LOG - PETER NEUFELDT NO. 1

Donald T. Ingling et al, Lease Owner

Section 15-21-4W

Donald T. Ingling, Contractor

Location: SW NE

Commenced: 5-13-66

County: McPherson

Completed: 5-28-66

Production:

Total Depth: 3935' (rotary)

Elevation: 1464 RB

Casing: 8 5/8" 587' (350 sacks cement)

Figures below indicate bottom formation

40	surface clay	3735	shale
150	red bed sandstone	3770	shale, sand and lime
355	shale, blue	3820	shale, sand and lime
465	salt and shale	3863	shale and sand
583	shale and lime	3875	sand
592	Anhydrite	3911	sand and shale
830	lime and shale	3930	lime
1070	shale	3935	lime
1300	lime and shale	3935	Total Depth
1580	lime and shale		
1780	lime and shale		
1925	shale and shells		
2015	lime and shale		
2115	lime and shale		
2230	lime		
2325	lime		
2450	lime and shale		
2620	shale and shells		
2720	lime		
2823	lime and shale		
2875	lime		
2955	lime		
3000	lime		
3110	shale		
3250	shale and lime		
3335	shale and lime		
3405	Mississippi		
3485	lime		
3528	lime		
3570	shale and lime		
3655	shale		

RECEIVED
STATE CORPORATION COMMISSION

JUN - 2 1966

CONSERVATION DIVISION
Wichita, Kansas

I certify this is a true and correct statement of the above mentioned well.

STATE OF KANSAS)
) ss.
SEDGWICK COUNTY)

Donald T. Ingling

Subscribed and sworn to before me, a Notary Public, in said county and state.

McBlack
Notary Public

My commission expires: Feb. 27, 1968