


STATE OF KANSAS  
STATE CORPORATION COMMISSION

Form CP-4

Give All Information Completely  
Make Required Affidavit  
Mail or Deliver Report to:  
Conservation Division  
State Corporation Commission  
P. O. Box 17027  
Wichita, Kansas 67217  
NORTH

WELL PLUGGING RECORD

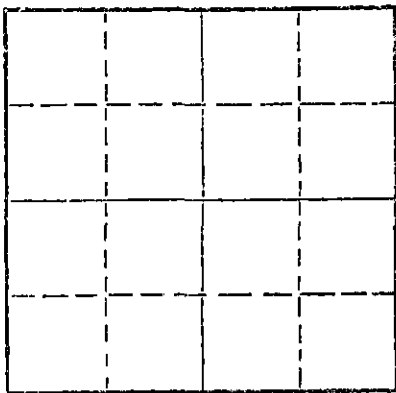

Locate well correctly on above Section Plat

*McPherson* County, Sec. *31* Twp. *21* Rge. *21W* (E) (W)  
Location as "NE/CNWSW" or footage from lines *31-215-1W-1650 S 990W OF NE*  
Lease Owner *Geo. Jones*  
Lease Name *Jones* Well No. *BFL*  
Office Address \_\_\_\_\_  
Character of Well (completed as Oil, Gas or Dry Hole) *Oil*  
Date well completed *6/29* 19 *60*  
Application for plugging filed \_\_\_\_\_ 19 \_\_\_\_\_  
Application for plugging approved \_\_\_\_\_ 19 \_\_\_\_\_  
Plugging commenced *5/22* 19 *74*  
Plugging completed *5/25* 19 *74*  
Reason for abandonment of well or producing formation *Low Prod.*

If a producing well is abandoned, date of last production \_\_\_\_\_ 19 \_\_\_\_\_  
Was permission obtained from the Conservation Division or its agents before plugging was commenced? *Yes*

Name of Conservation Agent who supervised plugging of this well *Hugh Scott*  
Producing formation \_\_\_\_\_ Depth to top \_\_\_\_\_ Bottom \_\_\_\_\_ Total Depth of Well *3330* Feet  
Show depth and thickness of all water, oil and gas formations.

OIL, GAS OR WATER RECORDS

CASING RECORD

FORMATION	CONTENT	FROM	TO	SIZE	PUT IN	PULLED OUT
				<i>5 1/2</i>	<i>3322</i>	<i>2537</i>

Describe in detail the manner in which the well was plugged, indicating where the mud fluid was placed and the method or methods used in introducing it into the hole. If cement or other plugs were used, state the character of same and depth placed, from \_\_\_\_\_ feet to \_\_\_\_\_ feet for each plug set.

*Pushed to plug to 2900 dump 5 sacks of cement. Ripped pipe 2537. Set in sock bridge from 250 to 240 - 25 sacks of cement. Mud to 40 sock bridge from 40 to 30 10 sacks to top*

RECEIVED  
STATE CORPORATION COMMISSION

JUN 14 1974


CONSERVATION DIVISION  
Wichita, Kansas

Name of Plugging Contractor *Be's Casing Pulling*  
Address *Towanda Kansas*

STATE OF *Kansas*, COUNTY OF *McPherson*, ss.  
(employee of owner) or (owner or operator) of the above-described well, being first duly sworn on oath, says: That I have knowledge of the facts, statements, and matters herein contained and the log of the above-described well as filed and that the same are true and correct. So help me God.

(Signature) *George R. Hess*

SUBSCRIBED AND SWORN TO before me this *13* day of *June*, 19 *74*  
*Carroll D. Winslow*  
Notary Public.

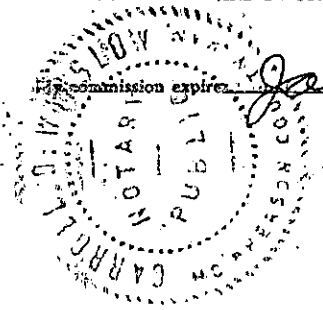

*January 17, 1977*

Casing Record

Location: 1650' S & 990' W of NE Crn.  
Section: 31-21S-2W 1/4  
McPherson County, Kansas  
Farm: Jones B-4  
Well Owner: Cities Service Oil Co.  
Contractor: White & Ellis Drig., Inc.  
Started: 6/16/60  
Completed:

8 5/8 222' Cemented  
w/150 sacks  
5 1/2 3372' Cemented  
w/150 sacks

T.D. 3375'  
Kelly Bushing Measurement 5' above ground level.

FORMATION	DEPTH
Soil	0-8
Sand & soil	30
Lime & river gravel	40
Shale & Lime	280
Lime	455
Shale	490
Lime	610
Lime & Shale	700
Red rock	720
Lime	860
Shale w/Lime stks.	1140
Shale & Shells	1220
Shale	1370
Lime	1500
Sand & Shale	1595
Lime	1655
Sand & Shale	1710
Shale & Lime	1775
Lime	1830
Shale w/Lime stks.	2010
Sand & Shale	2065
Lime & Shale	2107
Shale & Lime	2197
Lime	2206
Sand	2222
Sdy. Shale & Lime stks.	2297
Lime	2671
Shale	2700
Lime	2790
Lime & Shale	2857
Lime w/Shale stks.	2880
Sand	2885
Lime & Shale	2902
Lime	3211
Shale	3226
Lime	3234
Shale	3277
Lime	3339
Shale	3375

TOPS

Lansing	2297
Kansas City	2480
Mississippi	2902
Ft. Scott	3226
Hunton	3277

RECEIVED  
STATE CORPORATION COMMISSION  
APR 22 1974  
CONSERVATION DIVISION  
Wichita, Kansas