

15-009-06523-00-00

WELL PLUGGING RECORD


STATE OF KANSAS
STATE CORPORATION COMMISSION

FORMATION PLUGGING RECORD

Give All Information Completely
Make Required Affidavit
Mail or Deliver Report to:
Conservation Division
State Corporation Commission
800 Bittling Building
Wichita, Kansas

Strike out upper line
when reporting plug-
ging off formations.

NORTH

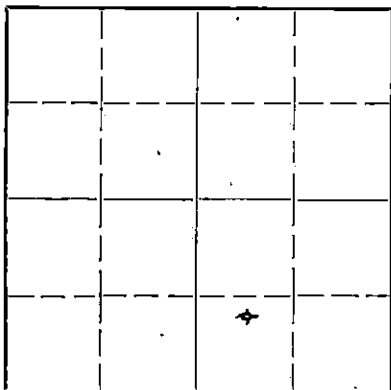

Locate well correctly on above
Section Plat

Barton County, Sec. 10 Twp. 16. Rge. -- (E) 12 (W)
Location as "NE 1/4 NW 1/4 SW 1/4" or footage from lines Gen. N/2 SW/4 SE/4
Lease Owner The Derby Oil Company, et al
Lease Name Christians Well No. 1
Office Address Wichita, Kansas
Character of Well (completed as Oil, Gas or Dry Hole) Dry Hole
Date well completed November 13 1943
Application for plugging filed November 15 1943
Application for plugging approved November 19 1943
Plugging commenced November 13 1943
Plugging completed November 13 1943
Reason for abandonment of well or producing formation Dry Hole
If a producing well is abandoned, date of last production 19
Was permission obtained from the Conservation Division or its agents before plugging was commenced? Yes

Name of Conservation Agent who supervised plugging of this well C. T. Alexander
Producing formation Arbuckle (Non-Prod.) Depth to top 3375' Bottom Total Depth of Well 3390' Feet
Show depth and thickness of all water, oil and gas formations.


OIL, GAS OR WATER RECORDS

CASING RECORD

Formation	Content	From	To	Size	Put In	Pulled Out
				8-5/8"	534	None

Describe in detail the manner in which the well was plugged, indicating where the mud fluid was placed and the method or methods used in introducing it into the hold. If cement or other plugs were used, state the character of same and depth placed, from feet to feet for each plug set.

3390' to 534' Mud and Dry hole plug
534' to 530' Rock Bridge
530' to 455' Cement
455' to 30' Mud - Dry hole plug
30' to 6' Cement
6' to Surface - Earth

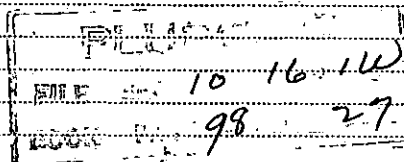

(If additional description is necessary, use BACK of this sheet)

Correspondence regarding this well should be addressed to The Derby Oil Company
Address Wichita, Kansas


STATE OF Kansas, COUNTY OF Sedgwick, ss.

S. E. Banks (employee of owner) or (owner or operator) of the above-described well,
being first duly sworn on oath, says: That I have knowledge of the facts, statements, and matters herein contained and the log of the above-described well as filed and that the same are true and correct. So help me God.

(Signature) S. E. Banks
Wichita, Kansas
(Address)

SUBSCRIBED AND SWORN to before me this 7th day of December, 1943

My commission expires 7/31/47

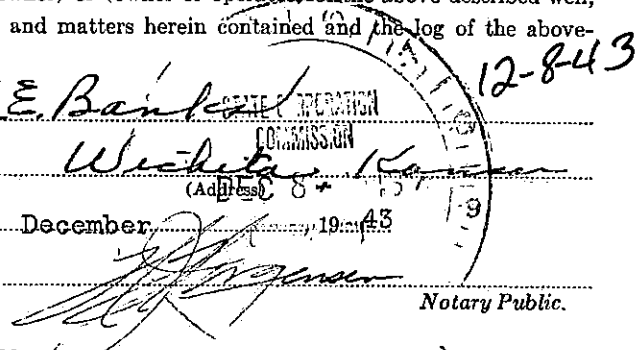

THE DERBY OIL COMPANY
et al

Record of Well No. 1 Christians Farm
 Location C N/2 SW SE Sec. 10 Twp. 16 Rge 12W
 Contractor Crow Drilling Company County Barton
 Drilling Commenced 10/28/43 State Kansas
 Elevation Est. 1905 Drilling completed 11/13/43

CASING RECORD

Size	Feet	Kind	Weight
8 5/8	534	New surface	165 Sax Bulk Cement by Halliburton

Formation	Bottom	Formation	Bottom
Shale - Shells	-105	Lime	3174
Shale & sand strks	330	Lime soft	3193
Sand	430	Lime	3261
Shale Shells	455	Soft Lime	3265
Shale	486	Lime	3343
Hard Sand	494	Congl.	3390
Red Rock	815		T.D.
Anhydrite	845		
Shale Shells	1242		
Salt & Shale Strks	1440		
Shale - Anhydrite	1510		
Anhydrite	1565		
Shale & Anhydrite strks	1620		
Shale & Shells	1663		
Bro. Lime & shale	1753		
Bro. Lime	1780		
Lime	1870		
Bro. Lime	1900		
Lime & Shale	1920		
Lime	1960		
Lime & Shale	2065		
Shale & Lime strks	2083		
Lime	2091		
Bro. Lime & Shale	2153		
Bro. Lime	2203		
Lime	2255		
Shale & Lime	2273		
Lime & Shale Strks	2337		
Shale & Lime	2672		
Lime	2702		
Lime Shale	2735		
Lime	3050		
Shale	3069		

GEOLOGICAL DATA

Tops:
 Topeka 2671
 Herbner shale 2999
 Kansas City 3086
 Cong. 3343
 Arb. 3375
 T.D. 3390

No show D&A

