

15-009-15723-00-00

STATE OF KANSAS
STATE CORPORATION COMMISSION

Form CP-4


WELL PLUGGING RECORD

Give All Information Completely
Make Required Affidavit
Mail or Deliver Report to:
Conservation Division
State Corporation Commission
211 No. Broadway
Wichita, Kansas

Barton County, Sec. 10 Twp. 16 Rge. 12 (E) W (W)

Location as "NE/CNW/SW" or footage from lines SE SW NW
Lease Owner Great Bend Pipe & Supply Company, Inc.
Lease Name Schauf Well No. 1
Office Address Great Bend, Kansas
Character of Well (completed as Oil, Gas or Dry Hole) _____
Date well completed _____ 19____
Application for plugging filed _____ 19____
Application for plugging approved _____ 19____
Plugging commenced 4-8-66 _____ 19____
Plugging completed 4-14-66 _____ 19____
Reason for abandonment of well or producing formation Depleted.

NORTH

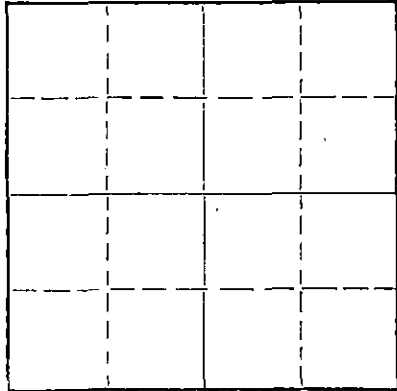

Locate well correctly on above
Section Plat

If a producing well is abandoned, date of last production _____ 19____
Was permission obtained from the Conservation Division or its agents before plugging was commenced? yes

Name of Conservation Agent who supervised plugging of this well Donald Truan
Producing formation _____ Depth to top _____ Bottom _____ Total Depth of Well 3304 Feet
Show depth and thickness of all water, oil and gas formations.

OIL, GAS OR WATER RECORDS

CASING RECORD

FORMATION	CONTENT	FROM	TO	SIZE	PUT IN	PULLED OUT
				8-5/8"	505'	None
				5-1/2"	3290'	2605'

Describe in detail the manner in which the well was plugged, indicating where the mud fluid was placed and the method or methods used in introducing it into the hole. If cement or other plugs were used, state the character of same and depth placed, from _____ feet to _____ feet for each plug set.

Checked hole to 3304', sanded hole to 3280' and dumped 5 sacks of cement @ 3280' with dump bailer. Pulled 5 1/2" casing, bailed hole to 350', set rock bridge to 340' and dumped 3 sacks of cement @ 340'. Mudded to 315', set rock bridge, bailed hole down and dumped 5 yards of ready mix cement to base of cellar.

RECEIVED
STATE CORPORATION COMMISSION

APR 28 1966

CONSERVATION DIVISION
Wichita, Kansas

PLUGGING COMPLETE.

(If additional description is necessary, use BACK of this sheet)

Name of Plugging Contractor KNIGHT CASING PULLING COMPANY
Address CHASE, KANSAS

STATE OF KANSAS, COUNTY OF RICHTER, ss.
Noel J. Knight (employee of owner) or (~~conservation agent~~) of the above-described well, being first duly sworn on oath, says: That I have knowledge of the facts, statements, and matters herein contained and the log of the above-described well as filed and that the same are true and correct. So help me God.

(Signature) Noel J. Knight
Chase, Kansas
(Address)

SUBSCRIBED AND SWORN TO before me this 26th day of April, 1966

My commission expires May 20, 1968

Milton J. Volin
Notary Public.

15-009-15723-00-00

KANSAS GEOLOGICAL SOCIETY
1000 National Bldg. Bldg. Wichita, Kansas


COPY

Company P ILLINOIS OIL CO.
Farm Schauff No. 1.

SEC. 10 T. 16 R. 12
SE SW 1/4

Total Depth. 3304
Comm 1-7-46 Comp. 1-19-46
Shut or Treated.
Contractor
issued. 5-18-46

County. Barton
KANSAS

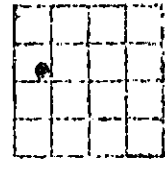

CASING:
8 5/8" 505' Ccm.
5 1/2" 3280' Ccm.

Elevation. _____

Production. Pot. 215 B

Figures indicate Section of Formations.

shale & shells	170
sand	210
shale & shells	340
sand & shale	405
sand	475
sand & shale	490
red rock	505
red bed	735
red bed & shale	1220
silt & shale	1435
lime & shale	1980
lime	1945
lime & shale	3225
lime	3275
lime & sand	3290
shale, sand & lime	3304
Total Depth	

Tops:

Kansas City	3034
Reagan Sand	3280

RECEIVED
STATE CONSERVATION COMMISSION
Wm. H. Wade
CONSERVATION DIVISION
Wichita, Kansas