

15-009-00308-00-00

STATE OF KANSAS
STATE CORPORATION COMMISSION

WELL PLUGGING RECORD

Give All Information Completely
Make Required Affidavit
Mail or Deliver Report to:
Conservation Division
State Corporation Commission
800 Bitting Building
Wichita, Kansas

Barton County, Sec. 11 Twp. 16 Rge. 12 (12) (W)

Location as "NE/CNW $\frac{1}{4}$ SW $\frac{1}{4}$ " or footage from lines SW-NW-SW

Lease Owner Fred J. Haynes

Lease Name Schauf Well No. 1

Office Address Bldg. & Loan Bldg. Russell, Kansas

Character of Well (completed as Oil, Gas or Dry Hole) D & A

Date well completed 3-16 19 56

Application for plugging filed 3-16 19 56

Application for plugging approved 3-16 19 56


Plugging commenced 3-16 19 56

Plugging completed 3-17 19 56

Reason for abandonment of well or producing formation

If a producing well is abandoned, date of last production 19

Was permission obtained from the Conservation Division or its agents before plugging was commenced? Yes

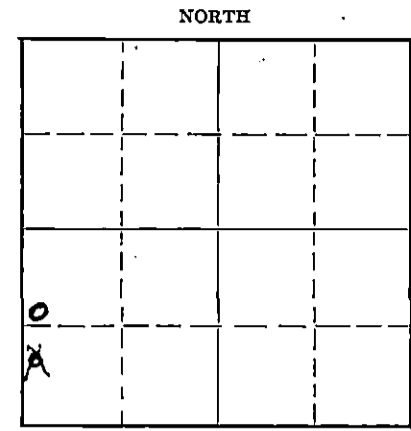

Locate well correctly on above Section Plat

Name of Conservation Agent who supervised plugging of this well R. M. Brundage

Producing formation Depth to top Bottom Total Depth of Well 3364 Feet

Show depth and thickness of all water, oil and gas formations.

OIL, GAS OR WATER RECORDS CASING RECORD

Formation	Content	From	To	Size	Put In	Pulled Out
Sand	Water	420	300	8 5/8	511	none
Sand	" "	440	500			

Describe in detail the manner in which the well was plugged, indicating where the mud fluid was placed and the method or methods used in introducing it into the hole. If cement or other plugs were used, state the character of same and depth placed, from feet to feet for each plug set.

Filled hole with mud from 3364 to 420' - Plug @ 420' with 25 sacks cement -- Mud from 420 to 35' and cement with 10 sacks cement.

RECEIVED
STATE CORPORATION COMMISSION
MARCH 22 1956
CONSERVATION DIVISION
WICHITA, KANSAS

3-22-56

(If additional description is necessary, use BACK of this sheet)

Correspondence regarding this well should be addressed to Fred J. Haynes
Address Bldg. & Loan Bldg. Russell, Kansas

STATE OF Kansas, COUNTY OF Russell, ss.

Fred J. Haynes (employee of owner) or (owner or operator) of the above-described well, being first duly sworn on oath, says: That I have knowledge of the facts, statements, and matters herein contained and the log of the above-described well as filed and that the same are true and correct. So help me God.

(Signature) Fred J. Haynes
(Address)

SUBSCRIBED AND SWORN to before me this 21 day of March, 19 56

Marguerite Byrnes Notary Public

My commission expires September 17, 1956

22-7877-8 4-49-10M

PLUGGING
FILE SEC 11 T 16 R 12W
BOOK PAGE 46 LINE 30

WILLIAMS LOG

Start 3-7-56
Comp 3-16-56

Schnaf # 1
SW-NW-SW
11-16-12
Barton Co., Ks.

I.P. D&A

Casing
8 5/8 - 511'

Clay & Shale	50
Shale & Shells	300
Sand & Shale	420
Shale	440
Sand & Iron	500
Shale	575
Red Rock	603
Lime	630
Shale & Shells	2605
Lime	2930
Shells	3055
Lime	3134
Shells	3364
T D	3364

SHOWS
2919 - DST
15' Mud, 30 Min.

<u>TOPS</u>	
Anhy	803
Topska	2683
Reebner	2972
Turonto	2991
Douglas	3004
Doug. Sand	3020
Brown Lime	3064
K.C.	3075
Shaley Cong	3334
Cherty Cong	3359

RECEIVED
TRANSMISSION
MAR 22 1956
CONSERVATION DIVISION,
Wichita, Kansas

PLUGGING
WELL SEC. 11 T 16 R 12W
BOOK PAGE 46 LINE 30