


WELL PLUGGING RECORD

Give All Information Completely  
Make Required Affidavit  
Mail or Deliver Report to:  
Conservation Division  
State Corporation Commission  
800 Bittling Building  
Wichita, Kansas

NORTH

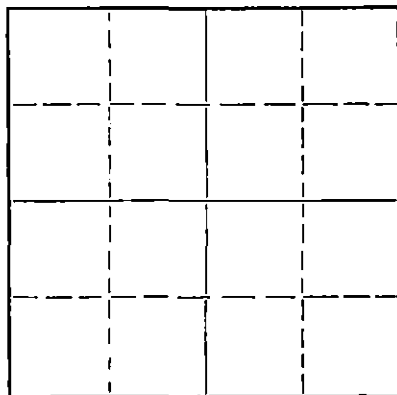

Locate well correctly on above  
Section Plat

Barton County. Sec. 11 Twp. 16 Rge. 12 (SE) (W)  
Location as "NE/CNW/SW" or footage from lines SW SW NW  
Lease Owner Musgrove Petroleum Corporation  
Lease Name Schauf Well No. 2  
Office Address 518 Petroleum Building, Wichita, Kansas  
Character of Well (completed as Oil, Gas or Dry Hole) Dry hole  
Date well completed December 24, 19 52  
Application for plugging filed December 31, 19 52  
Application for plugging approved 19 52  
Plugging commenced December 24, 19 52  
Plugging completed December 24, 19 52  
Reason for abandonment of well or producing formation Dry

If a producing well is abandoned, date of last production \_\_\_\_\_ 19 \_\_\_\_  
Was permission obtained from the Conservation Division or its agents before plugging was commenced? Yes

Name of Conservation Agent who supervised plugging of this well C.D. Stough Box 207, Great Bend, Kansas  
Producing formation \_\_\_\_\_ Depth to top \_\_\_\_\_ Bottom \_\_\_\_\_ Total Depth of Well 3380 Feet  
Show depth and thickness of all water, oil and gas formations.

OIL, GAS OR WATER RECORDS

CASING RECORD

FORMATION	CONTENT	FROM	TO	SIZE	PUT IN	PULLED OUT
				8 5/8"	352'	

Describe in detail the manner in which the well was plugged, indicating where the mud fluid was placed and the method or methods used in introducing it into the hole. If cement or other plugs were used, state the character of same and depth placed, from \_\_\_\_\_ feet to \_\_\_\_\_ feet for each plug set.

Set bottom plug at 300' with 1/2 sacks of hulls and 20 sacks of cement  
set top plug at 35' with 1/2 sacks of hulls and  
10 sacks of cement.

STATE CORPORATION COMMISSION  
JAN 2 1953  
1-2-53  
CONSERVATION DIVISION  
Wichita, Kansas

(If additional description is necessary, use BACK of this sheet)  
Name of Plugging Contractor Musgrove Petroleum Corporation  
Address 518 Petroleum Building, Wichita, Kansas


STATE OF Kansas, COUNTY OF Sedgwick, ss.  
Gordon L. Koelling (employee of owner) or (owner or operator) of the above-described well, being first duly sworn on oath, says: That I have knowledge of the facts, statements, and matters herein contained and the log of the above-described well as filed and that the same are true and correct. So help me God.

(Signature) Gordon L. Koelling  
518 Petroleum Bldg., Wichita, Kansas  
(Address)

SUBSCRIBED AND SWORN TO before me this 31st day of December, 19 52

Mary L. Ruman  
Notary Public.

My commission expires November 14, 1956

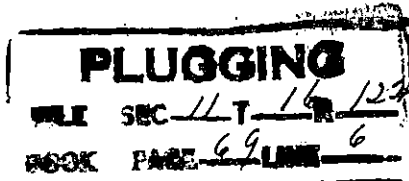

CONTRACTOR'S WELL LOG

COMPANY: Musgrove Petroleum Corporation  
 CONTRACTOR: Musgrove Petroleum Corporation  
 FARM: Schauf # 2  
 LOCATION: SW SW NW Section 11-16-12  
 Barton County, Kansas

COMMENCED: December 14, 1952  
 COMPLETED: December 24, 1952

0	40	Clay
40	650	Sand and red bed and shells
650	815	Shells and shale
815	855	Anhydrite
855	1975	Shale, lime and shells
1975	2070	Shale and lime
2070	3380	Lime and shale
	3380	Rotary total depth

Set 352' of 8 5/8" with 175 sacks of cement.

Dry and abandoned.

STATE OF KANSAS )

COUNTY OF SEDGWICK )

**RECEIVED**  
 STATE CORPORATION COMMISSION  
 JAN 2 - 1953  
 CONSERVATION DIVISION  
 Wichita

I, GORDON L. KOELLING, do hereby certify that the above and foregoing is a true and correct copy of the log of the Schauf # 2, Section 11-16-12, Barton County, as reflected by the files of the Musgrove Petroleum Corporation.

MUSGROVE PETROLEUM CORPORATION

By Gordon L. Koelling  
 Secretary-Treasurer

Subscribed and sworn to before me a Notary Public in and for Sedgwick County, Kansas, this 31st day of December, 1952.

Mary L. Hume  
 Notary Public

My Commission Expires: November 14, 1956.

**PLUGGING**  
 SEC 11 T 16 R 12 24  
 BOOK PAGE 69 LINE 6