


Give All Information Completely
Make Required Affidavit
Mail or Deliver Report to:
Conservation Division
State Corporation Commission
212 No. Market
Wichita, Kansas

WELL PLUGGING RECORD

NORTH

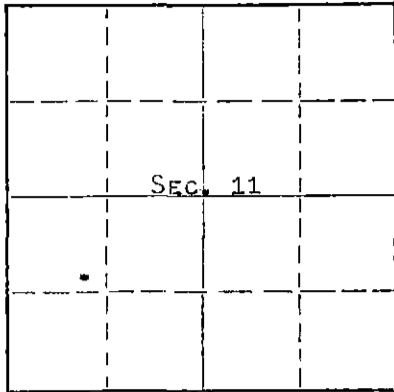

Locate well correctly on above
Section Plat

BARTON County. Sec. 11 Twp. 16s Rge. 12 (E) (W)
Location as "NE/CNW/SW" or footage from lines SE NW SW
Lease Owner PETROLEUM, INC.,
Lease Name SCHAUF Well No. B-2
Office Address R.R. #2, GREAT BEND, KANSAS
Character of Well (completed as Oil, Gas or Dry Hole) DRY HOLE
Date well completed DECEMBER 7 19 68
Application for plugging filed DECEMBER 7 19 68
Application for plugging approved DECEMBER 7 19 68
Plugging commenced DECEMBER 7 19 68
Plugging completed DECEMBER 7 19 68
Reason for abandonment of well or producing formation NO PRODUCIBLE ZONE

If a producing well is abandoned, date of last production NONE 19
Was permission obtained from the Conservation Division or its agents before plugging was commenced? YES

Name of Conservation Agent who supervised plugging of this well DONALD TRUAN
Producing formation Depth to top Bottom Total Depth of Well 3410 Feet
Show depth and thickness of all water, oil and gas formations.

OIL, GAS OR WATER RECORDS

CASING RECORD

FORMATION	CONTENT	FROM	TD	SIZE	PUT IN	PULLED OUT
				8-5/8	286'	NONE

Describe in detail the manner in which the well was plugged, indicating where the mud fluid was placed and the method or methods used in introducing it into the hole. If cement or other plugs were used, state the character of same and depth placed, from feet to feet for each plug set.

HEAVY MUD TO 500', FOLLOWED WITH 40 SACKS CEMENT.
HEAVY MUD TO 280', FOLLOWED WITH 25 SACKS CEMENT.
HEAVY MUD TO 40', WOODEN PLUG, 1/2 SACK HULLS, 10 SACKS
CEMENT ON TOP OF PLUG TO BASE OF WELL CELLAR.

RECEIVED
STATE CORPORATION COMMISSION
DEC 18 1968
CONSERVATION DIVISION
Wichita, Kansas

(If additional description is necessary, use BACK of this sheet)

Name of Plugging Contractor GARVEY DRILLING COMPANY
Address R.R. #2, GREAT BEND, KANSAS

STATE OF KANSAS, COUNTY OF BARTON, ss.
MONTE CHADD (employee of owner) or (~~owner or operator~~) of the above-described well, being first duly sworn on oath, says: That I have knowledge of the facts, statements, and matters herein contained and the log of the above-described well as filed and that the same are true and correct. So help me God. MONTE CHADD, DIST. PROD. SUPT.
(Signature) Monte Chadd
R.R. #2, GREAT BEND, KANSAS
(Address)

SUBSCRIBED AND SWORN TO before me this 16 day of DECEMBER, 19 68

My commission expires MAY 28, 1969

Richard W. Dumbler
Notary Public.

15-009-20322-00-00
WELL LOG

COMPANY Petroleum, Inc.

SEC. 11 T. 16S R. 12W

FARM Schauf NO. B-2


LOC. SE NW SW

TOTAL DEPTH 3410'

COUNTY Barton Co., Kansas

COMM. 11-30-68 COMP. 12-7-68

CONTRACTOR Garvey Drilling Company

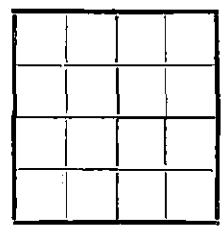

CASING 8 5/8" @ 286' w/190 sx

ELEVATION 1906' KB

PRODUCTION D & A

FIGURES INDICATE BOTTOM OF FORMATIONS

- 286' Post Rock
- 402' Shells & Sand
- 502' Pyrite
- 805' Shale & Shells
- 836' Anhydrite
- 1300' Shale
- 1640' Shale & Lime
- 1680' Shale
- 3070' Lime & Shale
- 3410' Lime
- 3410' RTD

RECEIVED
STATE CORPORATION COMMISSION
DEC 18 1968
CONSERVATION DIVISION
Wichita, Kansas

State of Kansas }
County of Barton } ss

I, Eunice McEachern of Garvey Drilling Company

upon oath state the above and foregoing is a true and correct copy of the log of the Schauf No. B-2 well.

Eunice McEachern

Subscribed and sworn to before me this 13th day of December 19 68

My Commission Expires: November 5th, 1969

Richard A. Boye
NOTARY PUBLIC