

15-185-60968-0000


STATE OF KANSAS
STATE CORPORATION COMMISSION

WELL PLUGGING RECORD

Give All Information Completely
Make Required Affidavit
Mail or Deliver Report to:
Conservation Division
State Corporation Commission
800 Bittin Building
Wichita, Kansas

Stafford County. Sec. 29 Twp. 23S Rge. (E) 14(W)

Location as "NE/CNW4SW4" or footage from lines. SW SE NE
Lease Owner Natural Gas & Oil Corporation and Republic Natrl Gas
Lease Name Gilmore Estate Well No. 1
Office Address 1009 Central Building, Wichita 2, Kansas
Character of Well (completed as Oil, Gas or Dry Hole) dry hole
Date well completed January 29, 1954 19
Application for plugging filed (orally) January 29, 1954 19
Application for plugging approved (written) February 1, 1954 19
Plugging commenced January 29, 1954 19
Plugging completed January 29, 1954 19
Reason for abandonment of well or producing formation

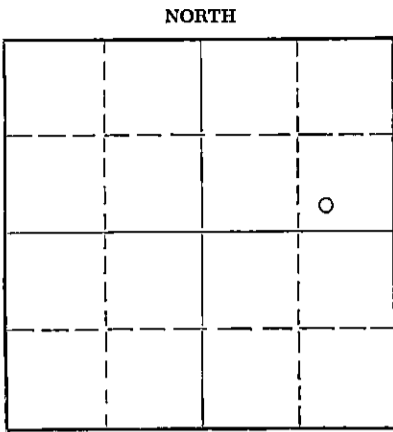

Locate well correctly on above
Section Plat

If a producing well is abandoned, date of last production 19
Was permission obtained from the Conservation Division or its agents before plugging was commenced? yes

Name of Conservation Agent who supervised plugging of this well M. A. Rives
Producing formation Depth to top Bottom Total Depth of Well Feet
Show depth and thickness of all water, oil and gas formations.

OIL, GAS OR WATER RECORDS

CASING RECORD

FORMATION	CONTENT	FROM	TO	SIZE	PUT IN	PULLED OUT
Surface		0	212	8 5/8"	212	none

Describe in detail the manner in which the well was plugged, indicating where the mud fluid was placed and the method or methods used in introducing it into the hole. If cement or other plugs were used, state the character of same and depth placed, from feet to feet for each plug set.

Filled hole with heavy mud from 4169 to 200 feet
Set plug at 200 feet and ran 20 sacks cement to 140 feet
Filled with heavy mud from 140 to 40 feet
Set plug at 40' and ran 10 sacks cement to cellar.

(If additional description is necessary, use BACK of this sheet)

Name of Plugging Contractor Drilling Department of Natural Gas & Oil Corporation
Address 1009 Central Building, Wichita 2, Kansas

STATE OF Kansas, COUNTY OF Sedgwick, ss.
Claud Sheats, Dist. Geologist (employee of owner or operator) of the above-described well, being first duly sworn on oath, says: That I have knowledge of the facts, statements, and matters herein contained and the log of the above-described well as filed and that the same are true and correct. So help me God.

(Signature) Claud Sheats
1009 Central Building, Wichita 2, Ks
(Address)

SUBSCRIBED AND SWORN TO before me this 2nd day of February, 1954

Esther Russell
Notary Public.

My commission expires May 25, 1957.

24-7366-5 3-53-20M

PLUGGING
FILE SEC 29 T 23 R 14W
BOOK PAGE 11 LINE 3

15-185-00968.0000

DRILLERS LOG

COMPANY: Natural Gas & Oil Corporation and
 Republic Natural Gas Company

CONTRACTOR: Drilling Department of
 Natural Gas and Oil Corporation

FARM: Gilmore Estate #1
 SW SE NE Sec 29-23S-14W,
 Stafford County, Kansas

COMMENCED: January 15, 1954

COMPLETED: January 29, 1954

ELEVATION: 1968 RB

0	to	60	Sand and clay
60	to	160	Clay
160	to	300	Shale and shells
300	to	420	Shale and sand
420	to	875	Red bed and shale
875	to	910	Anhydrite
910	to	1240	Shale and shells
1240	to	1510	Shale, salt and shells
1510	to	1700	Shale and shells
1700	to	1710	Lime
1710	to	1955	Lime and shale
1955	to	2335	Lime
2335	to	3145	Lime and shale
3145	to	3330	Lime
3330	to	3605	Shale and lime
3605	to	3875	Lime
3875	to	4015	Shale and lime
4015	to	4050	Lime and chert
4050	to	4070	Lime and shale
4070	to	4169	Lime
		4169	T. D. (RB)

Set 212' of 8 5/8" 25.5# surface. Cemented with 200 sacks cement and 4 sacks calcium chloride.

TOPS: Anhydrite 875	Lansing 3603	Simpson Sand 4029
Heebner 3452	Viola 3949	Arbuckle 4066
Brn Lime 3590	Simpson Shale 4013	

DRILL STEM TESTS:

- #1- 3789-3835, open 1 hr, weak blow 3 min; rec. 12' mud, SI 20 min
800# BHP.
- #2- 4033-70, open 1 hr, good blow 1 hr, rec. 57' sulphur water,
IFP 0#, FFP 350#, BHP 1275#, SI 30 min.
- #3- 4072-95, open 1 hr, 2940' sulphur water, IFP 1240#, FFP 1430#,
BHP 1450#.

Schlumberger Run
 DRY, PLUGGED AND ABANDONED

C E R T I F I C A T E

I, Claud Sheats, do hereby certify that the above and fore-
 going is a true and correct copy of the log of the Gilmore
 Estate No. 1, SW SE NE Section 29-23S-14W, Stafford County,
 Kansas, as reflected by files of the Natural Gas and Oil
 Corporation.

Claud Sheats

 Claud Sheats

Subscribed and sworn to before me, a Notary Public, within
 and for Sedgwick County, Kansas, this 2nd day of February,
 1954.

Esther Unsell

 Esther Unsell, Notary Public

My commission expires May 25, 1957.

PLUGGING

FILE SEC 29 T 23 S 14W

BOX PAGE 11 LINE 3