

15-185-00296-0000


STATE OF KANSAS
STATE CORPORATION COMMISSION

WELL PLUGGING RECORD

Give All Information Completely
Make Required Affidavit
Mail or Deliver Report to:
Conservation Division
State Corporation Commission
211 No. Broadway
Wichita, Kansas

Stafford County. Sec. 29 Twp. 23S Rge. (E) 14(W)
Location as "NE/CNW/SW" or footage from lines SW SW SW
Lease Owner Strata Drilling, Inc.
Lease Name Oshorne Well No. 1
Office Address P. O. Box 355, Great Bend, Kansas
Character of Well (completed as Oil, Gas or Dry Hole) Dry Hole
Date well completed October 19 1959
Application for plugging filed October 19 1959
Application for plugging approved October 19 1959
Plugging commenced October 19 1959
Plugging completed October 19 1959
Reason for abandonment of well or producing formation Dry Hole

NORTH

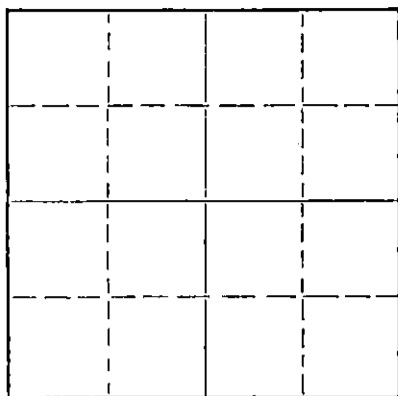

Locate well correctly on above
Section Plat

If a producing well is abandoned, date of last production 19
Was permission obtained from the Conservation Division or its agents before plugging was commenced? Yes

Name of Conservation Agent who supervised plugging of this well Frank Broadfoot, St. John, Kansas
Producing formation _____ Depth to top _____ Bottom _____ Total Depth of Well 1110 Feet
Show depth and thickness of all water, oil and gas formations.

OIL, GAS OR WATER RECORDS

CASING RECORD

FORMATION	CONTENT	FROM	TO	SIZE	PUT IN	PULLED OUT
				8-5/8"	230'	

Describe in detail the manner in which the well was plugged, indicating where the mud fluid was placed and the method or methods used in introducing it into the hole. If cement or other plugs were used, state the character of same and depth placed, from _____ feet to _____ feet for each plug set.

Plugged hole as follows: Plugged with 1/2 sack hulls, 20 sacks of cement through drill pipe, plug at 35' with 1/2 sack hulls and 10 sacks of cement. Job completed October 19, 1959.

RECEIVED
STATE CORPORATION COMMISSION
OCT 22 1959
CONSERVATION DIVISION
Wichita, Kansas

(If additional description is necessary, use BACK of this sheet)

Name of Plugging Contractor Strata Drilling, Inc.
Address P. O. Box 355, Great Bend, Kansas

STATE OF KANSAS, COUNTY OF BARTON, ss.
Jim B. McWilliams (employee of owner) or (owner or operator) of the above-described well, being first duly sworn on oath, says: That I have knowledge of the facts, statements, and matters herein contained and the log of the above-described well as filed and that the same are true and correct. So help me God.

(Signature) Jim B. McWilliams
Jim B. McWilliams
Box 355, Great Bend, Kansas
(Address)

SUBSCRIBED AND SWORN TO before me this 21th day of October, 19 59

My commission expires December 14, 1961
Elaine H. Taylor Notary Public.



15-189-00252-0000

D R I L L E R S L O G

CASING: 230' of 8-5/8" sur-face casing
COMPANY: Strata Drilling, Inc.
CONTRACTOR: Strata Drilling, Inc.
TOTAL DEPTH: 4110'
COMMENCED: October 11, 1959
COMPLETED: October 19, 1959

DESCRIPTION: SW SW SW Section 29-23S-14W Stafford County, Kansas
ELEVATION: 1982' RB
1977' GR

D. & A.

<u>FORMATION:</u>	<u>FROM</u>	<u>TO</u>	<u>REMARKS</u>
Sand	0	110	Ran 230' (11 Jts.) of used 8-5/8" surface casing; cemented with 175 sacks of cement, 2% C. C. and 4 sacks of gel.
Shale	110	232	
Red Bed	232	500	
Shale	500	890	
Anhydrite	890	915	
Shale & Anhydrite streaks	915	1500	
Shale & Shells	1500	1770	
Shale & Lime Streaks	1770	1980	
Shale & Lime	1980	3205	
Shale, Lime & Chalk	3205	3480	
Lime & Shale	3480	3610	DST #1 3940'-4005' tool open 1 hour, weak steady blow. Recovered 65' mud, no show of oil. IBHP 940 lbs. in 20 minutes. IFP 0 lbs. FFP 0 lbs. BHP 125 lbs. in 20 minutes.
Lime	3610	3680	
Lime & Chalk	3680	3760	
Lime	3760	3910	
Lime & Chert	3910	4007	
Chert	4007	4030	
Lime & Shale	4030	4080	
Lime & Chert	4080	4110	

Total Depth 4110

Top Anhydrite	890'	(-1092')	
Top Heebner	3458'	(-1476')	
Top Brown Lime	3593'	(-1611')	
Top Lansing	3605'	(-1623')	D. & A.
Top Viola	3943'	(-1961')	
Top Simpson	4024'	(-2042')	
Top Arbuckle	4088'	(-2106')	

STATE OF KANSAS)
) ss:
COUNTY OF BARTON)

I certify that this is a true and correct copy of the above log to the best of my knowledge.

STRATA DRILLING, INC.

Jim B. McWilliams
Jim B. McWilliams, Secy-Treas.

Subscribed and sworn to before me this 21th of October, 1959.

RECEIVED
CORPORATION COMMISSION

OCT 22 1959

NOTARY DIVISION
KANSAS

My Commission Expires:

December 14, 1961

Elaine H. Taylor
Elaine H. Taylor, Notary Public