

15-185-19462-0000

STATE OF KANSAS
STATE CORPORATION COMMISSION

Form CP-4


Give All Information Completely
Make Required Affidavit
Mail or Deliver Report to:
Conservation Division
State Corporation Commission
211 No. Broadway
Wichita, Kansas

WELL PLUGGING RECORD

STAFFORD County. Sec. 23 Twp. 23s Rge. 14 (E) (W)

Location as "NE/CNW%SW%" or footage from lines NW NE NE
Lease Owner PETROLEUM, INC.
Lease Name PILAND "B" Well No. 1
Office Address ROUTE #2, GREAT BEND, KANSAS
Character of Well (completed as Oil, Gas or Dry Hole) DRY HOLE
Date well completed FEBRUARY 27 1964
Application for plugging filed FEBRUARY 27 1964
Application for plugging approved FEBRUARY 27 1964
Plugging commenced FEBRUARY 27 1964
Plugging completed FEBRUARY 27 1964
Reason for abandonment of well or producing formation NO PRODUCIBLE ZONE

NORTH

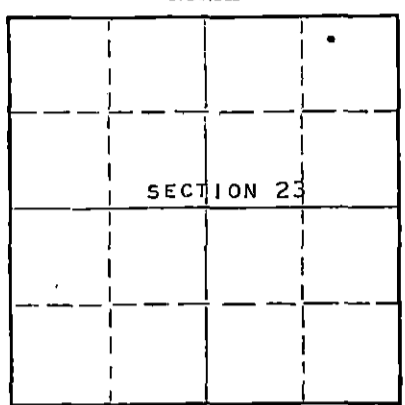

Locate well correctly on above
Section Plot

If a producing well is abandoned, date of last production - 19
Was permission obtained from the Conservation Division or its agents before plugging was commenced? YES

Name of Conservation Agent who supervised plugging of this well ARCHIE V. ELVING, PRATT, KANSAS
Producing formation - Depth to top - Bottom - Total Depth of Well 3755 Feet
Show depth and thickness of all water, oil and gas formations.

OIL, GAS OR WATER RECORDS CASING RECORD

FORMATION	CONTENT	FROM	TO	SIZE	PUT IN	PULLED OUT
				8-5/8"	254'	NONE

Describe in detail the manner in which the well was plugged, indicating where the mud fluid was placed and the method or methods used in introducing it into the hole. If cement or other plugs were used, state the character of same and depth placed, from feet to feet for each plug set.

MUDDED UP WITH HEAVY MUD TO 240', FOLLOWED BY A WOODEN PLUG AND 25 SACKS CEMENT. MUDDED UP WITH HEAVY MUD TO 40', FOLLOWED BY A WOODEN PLUG AND 10 SACKS CEMENT TO BASE OF WELL CELLAR.

RECEIVED
STATE CORPORATION COMMISSION

MAR 13 1964

CONSERVATION DIVISION
Wichita, Kansas

3-13-84

(If additional description is necessary, use BACK of this sheet)

Name of Plugging Contractor GARVEY DRILLING COMPANY
Address ROUTE #2, GREAT BEND, KANSAS

STATE OF KANSAS, COUNTY OF BARTON, ss.
MONTE CHADD (employee of owner) or (owner/agent) of the above-described well, being first duly sworn on oath, says: That I have knowledge of the facts, statements, and matters herein contained and the log of the above-described well as filed and that the same are true and correct. So help me God. MONTE CHADD, DIST. PROD. SUPT.

(Signature) *Monte Chadd*
R.R. #2, GREAT BEND, KANSAS
(Address)

SUBSCRIBED AND SWORN TO before me this 10TH day of MARCH 1964

My commission expires SEPTEMBER 23, 1967
Notary Public

WELL LOG

15-185-19462-0000

COMPANY Petroleum, Inc.

SEC. 23 T.23S R.14W

FARM Riland

NO. B-1

LOC. NW NE NE


TOTAL DEPTH 3755'

COUNTY Stafford

COMM. 2-19-64

COMP. 2-27-64

CONTRACTOR Garvey Drilling Company

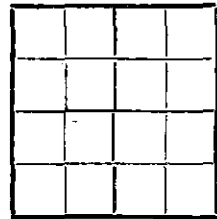

CASING 8 5/8" @ 254' w/270 sx

ELEVATION 1921' DF

PRODUCTION D & A

FIGURES INDICATE BOTTOM OF FORMATIONS

40' Sand
 254' Sand and Shale
 830' Shale and Red Bed
 860' Anhydrite
 1575' Shale
 1885' Lime and Shale
 2170' Lime
 2305' Lime and Shale
 2660' Shale and Lime
 2875' Shale and Shells
 3028' Shale
 3175' Shale and Lime
 3351' Lime
 3520' Shale and Lime
 3755' Lime
 3755' RTD

RECEIVED
STATE CORPORATION COMMISSION

MAR 13 1964

CONSERVATION DIVISION
Wichita, Kansas

State of Kansas }
County of Barton } ss

I, Sam N. Stephens of Garvey Drilling Company

upon oath state the above and foregoing is a true and correct copy of the log of the Piland B-1 well.

Sam N. Stephens

Subscribed and sworn to before me this 3rd day of March 19 64

My Commission Expires: September 23rd, 1967

Howard E. Steiner
NOTARY PUBLIC