

WELL PLUGGING RECORD

Give All Information Completely
Make Required Affidavit
Mail or Deliver Report to:
Conservation Division
State Corporation Commission
212 North Market, Insurance Bldg.
Wichita, Kansas

Stafford County. Sec. 23 Twp. 23 Rge. 14 (E) W (W)

Location as "NE/CNW&SW&" or footage from lines NW 1/4 SE 1/4 NE 1/4

Lease Owner Chas. Hulme Drilling Contr.

Lease Name Piland Well No. 1

Office Address P. O. Box 836, Great Bend, Kansas

Character of Well (completed as Oil, Gas or Dry Hole) Dry Hole

Date well completed 4-19-63 19 63

Application for plugging filed 4-19-63 19 63

Application for plugging approved 4-19-63 19 63


Plugging commenced 4-19-63 19 63

Plugging completed 4-19-63 19 63

Reason for abandonment of well or producing formation Dry Hole

If a producing well is abandoned, date of last production 19

Was permission obtained from the Conservation Division or its agents before plugging was commenced? Yes

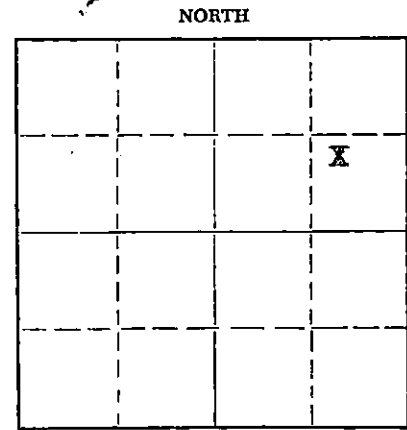

Locate well correctly on above Section Plat

Name of Conservation Agent who supervised plugging of this well Archie Elwing, Pratt, Kansas

Producing formation Depth to top Bottom Total Depth of Well 3975 Feet

Show depth and thickness of all water, oil and gas formations.

OIL, GAS OR WATER RECORDS

CASING RECORD

FORMATION	CONTENT	FROM	TO	SIZE	PUT IN	PULLED OUT
Surface Pipe		0'	235'	8 5/8"	235'	None

Describe in detail the manner in which the well was plugged, indicating where the mud fluid was placed and the method or methods used in introducing it into the hole. If cement or other plugs were used, state the character of same and depth placed, from feet to feet for each plug set.

First Plug set at 180', 1/2 sack hulls and plug, 20 sacks cement on top of plug.
Filled with mud to 40', set plug and put 10 sacks cement of top of plug.

RECEIVED
STATE CORPORATION COMMISSION

MAY 10 1963

CONSERVATION DIVISION
Wichita, Kansas

(If additional description is necessary, use BACK of this sheet)

Name of Plugging Contractor Self
Address Same

STATE OF Kansas COUNTY OF Barton, ss.
C. E. Byars

(owner or operator) or (owner or operator) of the above-described well, being first duly sworn on oath, says: That I have knowledge of the facts, statements, and matters herein contained and the log of the above-described well as filed and that the same are true and correct. So help me God.

(Signature) C. E. Byars

P. O. Box 836, Great Bend, Kansas (Address)

SUBSCRIBED AND SWORN TO before me this 9th day of May, 1963

My commission expires 4-27-65

Notary Public.

15-185-19464-0000

CHAS. HULME DRILLING CONTRACTOR
P. O. Box 836
Great Bend, Kansas

Piland # 1 NW SE NE 23-23-14 Barton County, Kansas

			Elevation	
0	55	Sand		1925' D.F.
55	235	Shale & Shells		1928' R.B.
235	805	Red Bed and Sand		
805	840	Red Bed	Anhydrite	833' + 1095'
840	855	Anhydrite	Hebner	3393' - 1465'
855	1235	Shale and Shells	Douglas	3415' - 1487'
1235	1600	Shale	Brown Lime	3531' - 1603'
1600	1800	Lime and Shale	Kansas City	3541' - 1613'
1800	2185	Lime		#
2185	2350	Lime and Shale		
2350	2550	Shale and Shells		
2550	2710	Lime and Shale		
2710	2875	Lime, Shell, Shales		
2875	3000	Lime		
3000	3135	Lime and Shale		
3135	3800	Lime		
3800	3865	Lime and Shale		
3865	3873	Lime		
3873	3922	Conglomerate		
3922	3969	Lime, Shale and Chert		
3969	3975	Lime & Shale		
3975		Rotary T.D.		

STATE OF KANSAS
MAY 10 1963
CONSERVATION DIVISION

8 5/8" casing set @ 235' cemented with 225 sacks cement.

DST #1

Packer set @ 3700'. TD 3725'. Open 30 minutes. Recovered 225' salt water. BHP 1255#.

STATE OF KANSAS
COUNTY OF BARTON ss

Virgil E. Belford, Jr., employee of Chas. Hulme Drilling Contractor being first duly sworn on oath says: That I have knowledge of the facts, statement, and matters herein contained and the log of the above described well as filed and that the same are true and correct.

Virgil E. Belford, Jr.
Virgil E. Belford, Jr.

Subscribed and sworn before me this 8th day of May, 1963.

Jean Kimber
Notary Public Barton County

My Commission Expires: 12-3-63.