

STATE OF KANSAS  
STATE CORPORATION COMMISSION

Form CP-4

WELL PLUGGING RECORD

Give All Information Completely  
Make Required Affidavit  
Mail or Deliver Report to:  
Conservation Division  
State Corporation Commission  
211 No. Broadway  
Wichita, Kansas

McPherson County, Sec. 15 Twp. 21S Rge. 1 (E) W (W)

Location as "NE/CNW/SW" or footage from lines NW NE SE

Lease Owner National Associated Petro. Co.

Lease Name Dirksen Well No. 1

Office Address 502 Ritz Bldg., Tulsa, Oklahoma

Character of Well (completed as Oil, Gas or Dry Hole) dry hole

Date well completed 10-21 19 65

Application for plugging filed 10-21 19 65

Application for plugging approved 10-21 19 65


Plugging commenced 10-21 19 65

Plugging completed 10-21 19 65

Reason for abandonment of well or producing formation Dry Hole

If a producing well is abandoned, date of last production 19

Was permission obtained from the Conservation Division or its agents before plugging was commenced? yes

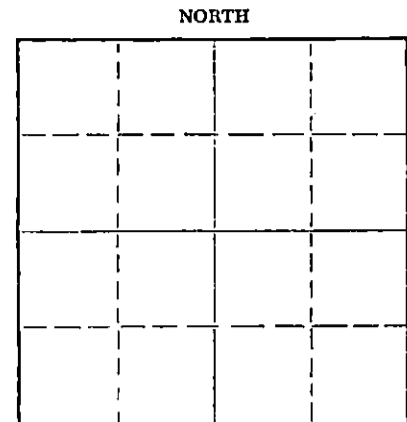

Locate well correctly on above Section Flat

Name of Conservation Agent who supervised plugging of this well Gilbert Toman

Producing formation Depth to top Bottom Total Depth of Well 3560 Feet

Show depth and thickness of all water, oil and gas formations.

OIL, GAS OR WATER RECORDS

CASING RECORD

FORMATION	CONTENT	FROM	TO	SIZE	PUT IN	PULLED OUT
				8 5/8	208'	

Describe in detail the manner in which the well was plugged, indicating where the mud fluid was placed and the method or methods used in introducing it into the hole. If cement or other plugs were used, state the character of same and depth placed, from feet to feet for each plug set.

Hole filled with fluid to 240', 1/2 sack of hulls. Bridge at 240' with hulls and 15 sacks ceemnt. Hole filled with mud to 30'. Bridge at 30' with hulls and 8 sacks cement. Rathole capped with 2 sacks cement.

RECEIVED  
STATE CORPORATION COMMISSION

NOV 24 1965

CONSERVATION DIVISION  
Wichita, Kansas

(If additional description is necessary, use BACK of this sheet)

Name of Plugging Contractor WHITE & BELLIS DRILLING, INC. License #209

Address Box 448, El Dorado, Kansas

STATE OF OKLAHOMA, COUNTY OF TULSA, ss.

Joe E. McGarrah (employee of owner) or (owner or operator) of the above-described well, being first duly sworn on oath, says: That I have knowledge of the facts, statements, and matters herein contained and the log of the above-described well as filed and that the same are true and correct. So help me God.

(Signature) Joe E. McGarrah  
504 Ritz Bldg., Tulsa  
(Address)

SUBSCRIBED AND SWORN to before me this 23rd day of November, 19 65

My commission expires February 21, 1969

Maxine D. Provine  
Maxine D. Provine Notary Public.

Casing Record

15.113.30083.0000

Location: NW NE SE  
Section: 15-21S-1W  
McPherson County, Kansas  
Farm: Dirksen #1  
Well Owner: National Association  
Petroleum Co.  
Contractor: White & Ellis  
Drilling, Inc.  
Commenced: 10-9-65  
Completed: 10-21-65

8 5/8

208' Cemented  
w/150 Sacks

T. D.

3560'

Kelly Bushing Measurement 5' above ground level.

FORMATION	DEPTH
Shale & Sand	208
Shale	340
Lime & Shale	515
Shale & Lime	952
Lime	1010
Shale & Lime	1165
Shale & Shells	1435
Shale & Lime	1520
Lime	1570
Sandy Shale	1655
Lime & Shale	1715
Shale & Lime	1772
Lime	1885
Lime & Shale	1915
Shale & Sand	1975
Lime & Shale	2182
Sand	2268
Lime	2298
Shale & Lime	2350
Lime	2762
Shale & Lime	2880
Lime & Shale	2970
Chert	2986
Lime & Chert	3022
Lime	3328
Shale	3428
Lime	3450
Shale	3513
Lime	3535
Sand	3560

TOPS

Lansing	2350
B/Kansas City	2720
Mississippi chert	2970
Mississippi lime	3022
B/Mississippi	3313
Hunton	3428

RECEIVED  
STATE CORPORATION COMMISSION

NOV 24 1965

CONSERVATION DIVISION  
Wichita, Kansas

Dry Hole, Plugged

& Abandoned