


STATE OF KANSAS
STATE CORPORATION COMMISSION

Give All Information Completely
Make Required Affidavit
Mail or Deliver Report to:
Conservation Division
State Corporation Commission
800 Rating Building
Wichita, Kansas

WELL PLUGGING RECORD

NORTH

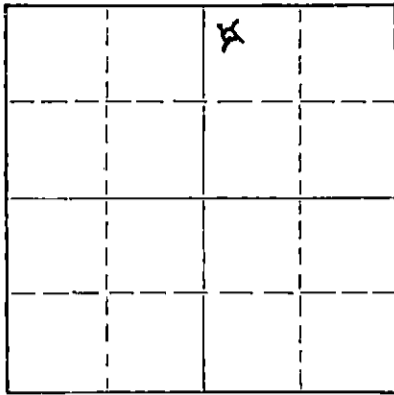

Locate well correctly on above
Section Plat

Mc Pherson County. Sec. 15 Twp. 21 Rge. 1 (2) (W)
Location as "NE/CNW/SW" or footage from lines NW NW NE
Lease Owner Norbrook Inc.
Lease Name Unruh Well No. 1
Office Address Peoples St. Bank Bldg., Mc Pherson, Kansas
Character of Well (completed as Oil, Gas or Dry Hole) Dry
Date well completed March 19 19 59
Application for plugging filed "Oral APRIL 16" 19 59
Application for plugging approved "APRIL 16" 19 59
Plugging commenced " " 19
Plugging completed " " 19
Reason for abandonment of well or producing formation _____

If a producing well is abandoned, date of last production _____ 19
Was permission obtained from the Conservation Division or its agents before plugging was commenced? yes--oral

Name of Conservation Agent who supervised plugging of this well G. J. Toman, Holyrood
Producing formation _____ Depth to top _____ Bottom _____ Total Depth of Well 3305 Feet
Show depth and thickness of all water, oil and gas formations.

OIL, GAS OR WATER RECORDS

CASING RECORD

FORMATION	CONTENT	FROM	TO	SIZE	PUT IN	PULLED OUT
				8 5/8"	205	none

Describe in detail the manner in which the well was plugged, indicating where the mud fluid was placed and the method or methods used in introducing it into the hole. If cement or other plugs were used, state the character of same and depth placed, from _____ feet to _____ feet for each plug set.

Filled hole full of heavy mud to 205'
Drove wooden plug to 205' and dumped in 20 sacks cement.
Finished filling hole full heavy mud to 40' of cellar and
dumped in 10 sacks cement.

RECEIVED
STATE CORPORATION COMMISSION
APR 16 1959
CONSERVATION DIVISION

(If additional description is necessary, use BACK of this sheet)

Name of Plugging Contractor Mallard Drilling Company
Address 419 Union National Bldg.

STATE OF Kansas COUNTY OF Sedgwick ss.
C. C. Nelson, partner Mallard Drg. Co. (employee of owner) or (owner or operator) of the above-described well, being first duly sworn on oath, says: That I have knowledge of the facts, statements, and matters herein contained and the log of the above-described well as filed and that the same are true and correct. So help me God.

(Signature) C. C. Nelson

(Address) _____

SUBSCRIBED AND SWORN to before me this 15th day of April, 19 59

Edward V. Saag
Notary Public.

My commission expires March 12, 1962

PLUGGING
FILE SEC. 15 T. 21 R. 1W
BOOK PAGE 30 LINE 11

APR 18 1959
 COMPLETION DIVISION
 FIELD OFFICE

COMPANY: Norbrook Inc.
 CONTRACTOR: Mallard Drilling Company
 FARM: Unruh #1
 LOCATION: NW NW NE Sec. 15-21-1W
 Mc Pherson County, Kansas
 COMMENCED: March 9, 1959
 COMPLETED: March 19, 1959

0	to	30	Shale
30	to	70	Shale and shells
70	to	205	Shale and shells
205	to	400	Shale
400	to	590	Shale and shells
590	to	800	Lime
800	to	1455	Lime and shale
1455	to	1975	Lime and shale
1975	to	2115	Lime
2115	to	2343	Shale and lime
2343	to	2540	Lime
2540	to	2620	Lime
2620	to	2855	Lime and shale
2855	to	2961	Shale and lime
2961	to	3147	Mississippi
3147	to	3181	Chert and lime
3181	to	3255	Mississippi lime
3255	to	3403	Lime and shale
3403	to	3410	Lime-Hunton
3410	to	3490	Lime
3490	to	3305	Lime
		3305	T.D.

Set 205 feet of 8 5/8" surface pipe. Cemented with 140 sacks cement.

TOPS: Chat -- 2961 Hunter -- 3403 Villa -- 3484

Measurements taken from R.D.B. R.D.B. 5 1/2' from ground level.

DRY, ABONDED AND PLUGGED.

C E R T I F I C A T E

I, G. C. Nelson, do hereby certify that the above and foregoing is a true and correct copy of log of the Unruh #1, as reflected by filed of the Mallard Drilling Company.

G. C. Nelson

Subscribed and sworn to before me a Notary Public, within and for Sedgwick County, Kansas, this 23rd day of March 1959.

Edward D. Searge

My commission expires March 12, 1962

PLUGGING
 FILE SEC. 15 T. 21 R. 1W
 BOOK PAGE 36 LINE 11