

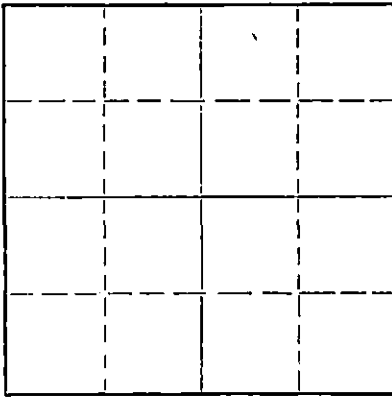
STATE OF KANSAS
STATE CORPORATION COMMISSION

Form CP-4

Give All Information Completely
Make Required Affidavit
Mail or Deliver Report to:
Conservation Division
State Corporation Commission
211 No. Broadway
Wichita, Kansas

WELL PLUGGING RECORD

NORTH

Locate well correctly on above
Section Plat

McPherson County, Sec. 15 Twp. 21S Rge. (X) 1 (W)

Location as "NE/CNW/SW" or footage from lines NW SE NW

Lease Owner Kern Drilling Company, Inc.

Lease Name Thies Well No. 1

Office Address P. O. Box 699, Magnolia, Arkansas

Character of Well (completed as Oil, Gas or Dry Hole) Dry Hole

Date well completed November 25, 19 67

Application for plugging filed November 25, 19 67

Application for plugging approved November 25, 19 67

Plugging commenced November 25, 19 67

Plugging completed November 25, 19 67

Reason for abandonment of well or producing formation

If a producing well is abandoned, date of last production 19

Was permission obtained from the Conservation Division or its agents before plugging was commenced? Yes

Name of Conservation Agent who supervised plugging of this well Cecil M. Jones, McPherson, Kansas

Producing formation Depth to top Bottom Total Depth of Well 3445 Feet

Show depth and thickness of all water, oil and gas formations.

OIL, GAS OR WATER RECORDS

CASING RECORD

FORMATION	CONTENT	FROM	TO	SIZE	PUT IN	PULLED OUT
				8-5/8"	220'	None

Describe in detail the manner in which the well was plugged, indicating where the mud fluid was placed and the method or methods used in introducing it into the hole. If cement or other plugs were used, state the character of same and depth placed, from feet to feet for each plug set.

Mudded up with heavy mud to 190 feet. Followed by wooden plug and 1/2 sack hulls. Placed 25 sacks cement onto hulls. Mudded up with heavy mud to 40 feet followed by wooden plug, 1/2 sack hulls and 10 sacks cement to base of well cellar. Plugged rat hole with 2 sacks cement.

RECEIVED
STATE CORPORATION COMMISSION

DEC 1 1967

CONSERVATION DIVISION
Wichita, Kansas

(If additional description is necessary, use BACK of this sheet)

Name of Plugging Contractor Graves Drilling Co., Inc.

Address 505 Union Center, Wichita, Kansas 67202

STATE OF KANSAS, COUNTY OF SEDGWICK, ss.

John C. Graves (employee of owner) or (owner or operator) of the above-described well, being first duly sworn on oath, says: That I have knowledge of the facts, statements, and matters herein contained and the log of the above-described well as filed and that the same are true and correct. So help me God.

(Signature)

505 Union Center, Wichita, Kansas 67202

(Address)

SUBSCRIBED AND SWORN to before me this 30th day of November, 19 67

My commission expires May 9, 1971

Betty Brandt

Notary Public.

R O T A R Y D R I L L E R S' L O G

OPERATOR: Kern Drilling Company, Inc. DRILLING COMMENCED: November 17, 1967
P. O. Box 699
Magnolia, Arkansas

CONTRACTOR: Graves Drilling Co., Inc. DRILLING COMPLETED: November 25, 1967
505 Union Center
Wichita, Kansas

CASING RECORD: 10 Jts. 220' 8-5/8" LOCATION: Thies No. 1
cemented with 290 sacks NW SE NW
Section 15-21S-1W
McPherson County, Kansas

0 - 175 Sod, sand & shale
175 - 220 Lime
220 - 425 Shale
425 - 1192 Lime & shale
1192 - 1710 Shale with lime streaks
1710 - 2045 Lime & shale
2045 - 2116 Lime
2116 - 2148 Shale & lime
2148 - 2337 Shale & lime streaks
2337 - 2671 Lime
2671 - 2970 Lime & shale
2970 - 3025 Lime
3025 - 3085 Lime & chert
3085 - 3143 Cherty lime
3143 - 3280 Lime
3280 - 3395 Shale
3395 - 3413 Lime
3413 - 3445 Shale
3445 Rotary Total Depth

RECEIVED
STATE CORPORATION COMMISSION

DEC 1 1967

I hereby certify the foregoing statements to be true and correct to the best of my knowledge.

Wichita, Kansas

GRAVES DRILLING CO., INC.

By Phil Graves President

STATE OF KANSAS)
) SS:
SEDGWICK COUNTY)

Subscribed and sworn to before me, a Notary Public, this 30th of November, 1967.

Betty Brandt
Betty Brandt Notary Public

My commission expires: May 9, 1971.

Copy to Corporation Commission
Copy to Hall of Records